


1 LOCATION OF WATER WELL:	Fraction	Section Number	Township Number	Range Number
County: <u>Grant</u>	SW 1/4 SW 1/4 SW 1/4	11	T 27 S	R 38 E <u>(W)</u>

Distance and direction from nearest town or city street address of well if located within city?
 8 miles north, 5 west of Ulysses, Kansas

2 WATER WELL OWNER: Fern Schubert
 RR#, St. Address, Box #: 5770 W. Rd 3
 City, State, ZIP Code: Ulysses, Kansas
 Board of Agriculture, Division of Water Resources
 Application Number:

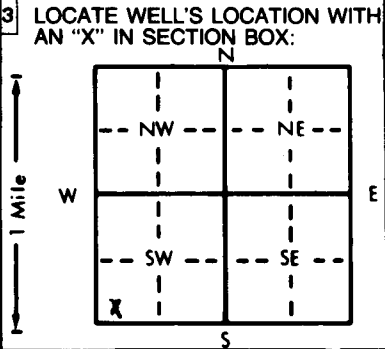

4 DEPTH OF COMPLETED WELL: 31.7 ft. ELEVATION: slope
 Depth(s) Groundwater Encountered 1. 14.0 ft. 2. ft. 3. ft.
 WELL'S STATIC WATER LEVEL: 14.0 ft. below land surface measured on mo/day/yr 8-15-96
 Pump test data: Well water was 150 ft. after 3 hours pumping 10 gpm
 Est. Yield 1.5 gpm; Well water was ft. after hours pumping gpm
 Bore Hole Diameter 9 7/8 in. to 31.7 ft., and in. to ft.
 WELL WATER TO BE USED AS:
 1 Domestic 3 Feedlot 6 Oil field water supply 9 Dewatering 12 Other (Specify below)
 2 Irrigation 4 Industrial 7 Lawn and garden only 10 Monitoring well
 Was a chemical/bacteriological sample submitted to Department? Yes.....No.....X; If yes, mo/day/yr sample was submitted
 Water Well Disinfected? Yes X No

5 TYPE OF BLANK CASING USED:
 1 Steel 3 RMP (SR) 5 Wrought iron 8 Concrete tile CASING JOINTS: Glued X Blamped & riveted
 2 PVC 4 ABS 6 Asbestos-Cement 9 Other (specify below) Welded
 7 Fiberglass Threaded
 Blank casing diameter 5 in. to 17.7 ft., Dia 5 in. to 27.7 ft., Dia in. to ft.
 Casing height above land surface in., weight lbs./ft. Wall thickness or gauge No.
 TYPE OF SCREEN OR PERFORATION MATERIAL:
 7 PVC 10 Asbestos-cement
 1 Steel 3 Stainless steel 5 Fiberglass 8 RMP (SR) 11 Other (specify)
 2 Brass 4 Galvanized steel 6 Concrete tile 9 ABS 12 None used (open hole)
 SCREEN OR PERFORATION OPENINGS ARE:
 1 Continuous slot 3 Mill slot 5 Gauzed wrapped 8 Saw cut 11 None (open hole)
 2 Louvered shutter 4 Key punched 6 Wire wrapped 9 Drilled holes
 7 Torch cut 10 Other (specify)
 SCREEN-PERFORATED INTERVALS: From 1.97 ft. to 27.7 ft., From ft. to ft.
 From 2.77 ft. to 31.7 ft., From ft. to ft.
 GRAVEL PACK INTERVALS: From 2.77 ft. to 31.7 ft., From ft. to ft.
 From ft. to ft., From ft. to ft.

6 GROUT MATERIAL: 1 Neat cement 2 Cement grout 3 Bentonite 4 Other
 Grout Intervals: From 4 ft. to 24 ft., From ft. to ft., From ft. to ft.
 What is the nearest source of possible contamination:
 1 Septic tank 4 Lateral lines 7 Pit privy 10 Livestock pens 14 Abandoned water well
 2 Sewer lines 5 Cess pool 8 Sewage lagoon 11 Fuel storage 15 Oil well/Gas well
 3 Watertight sewer lines 6 Seepage pit 9 Feedyard 12 Fertilizer storage 16 Other (specify below)
 13 Insecticide storage
 Direction from well? East How many feet? 150

FROM	TO	LITHOLOGIC LOG	FROM	TO	PLUGGING INTERVALS
0	2	Surface			
2	30	Clay and lime			
30	85	Coarse sand & gravel w/cemented strips			
85	130	Medium sand w/clay breakers & cemented strips			
130	165	Gray clay w/lime shells & strips of sandstone			
165	183	Yellow chalk, gray clay, w/sandstone strips			
183	240	Brown shale w/rock shells			
240	315	Blue shale w/rock shells and sandstone			

7 CONTRACTOR'S OR LANDOWNER'S CERTIFICATION: This water well was (1) constructed, (2) reconstructed, or (3) plugged under my jurisdiction and was completed on (mo/day/year) 8-15-96 and this record is true to the best of my knowledge and belief. Kansas Water Well Contractor's License No. 164. This Water Well Record was completed on (mo/day/yr) 8-27-96 under the business name of Houck Bros. Drig. Co. by (signature) M. Beard

INSTRUCTIONS: Use typewriter or ball point pen. PLEASE PRESS FIRMLY and PRINT clearly. Please fill in blanks, underline or circle the correct answers. Send top three copies to Kansas Department of Health and Environment, Bureau of Water, Topeka, Kansas 66620-0001. Telephone: 913-296-5545. Send one to WATER WELL OWNER and retain one for your records.