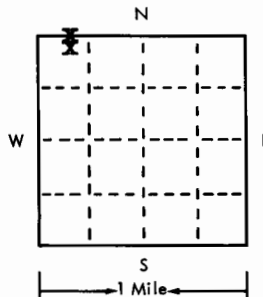
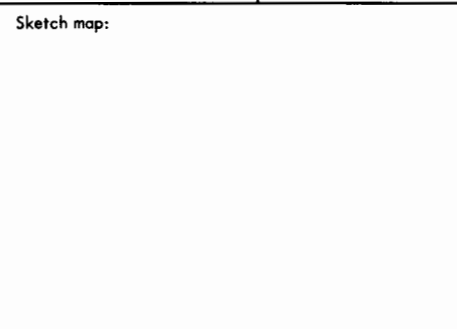


USE TYPEWRITER OR BALL POINT PEN-PRESS FIRMLY, PRINT CLEARLY.

T R EW sec 1/4 1/4 1/4 No.

WATER WELL RECORD  
KSA 82a-1201-1215

Kansas State Dept. Of Health  
(Water Well Contractors)  
Forbes-Bldg. 740  
Topeka, Kansas 66620

1 Location of well:	County <b>Grant</b>	Township name	Fraction <b>NW<math>\frac{1}{4}</math> NW<math>\frac{1}{4}</math></b>	Section number <b>7</b>	Town number <b>27</b>	Range number <b>38</b>
Distance and direction from nearest town or city: <b>9 mi north-8 3/4 mi west of Ulysses, Ks.</b> Street address of well location if in city:				3 Owner of well: <b>Merl Rider</b> Address: <b>Rte#3, Ulysses, Ks. 67880</b>		
Locate with "X" in section below: 				Sketch map: 		
2 Type and color of material				From	To	
Clay				0	60	
Sand, gravel				60	100	
Clay, gyp rock, sev eral Kelly drops				100	140	
Granulated clay, some sandstone				140	160	
Clay, sandstone				160	180	
Sandy, sandstone				180	200	
Good sandstone (lost circ. several times)				200	320	
Shale				320	420	
Clay, sandstone				420	440	
Clay, sandstone				440	460	
Sandstone, clay pebbles				460	530	
16 Remarks: elevation  Topography: <input type="checkbox"/> Hill <input type="checkbox"/> Slope <input checked="" type="checkbox"/> Upland <input type="checkbox"/> Valley  <b>On the level</b>						
				(use a second sheet if needed)		
				4 Well depth: <b>529</b> ft. Date of completion <b>3-15-75</b> Well diameter <b>26</b> in.		
				5 <input type="checkbox"/> Cable tool <input checked="" type="checkbox"/> Rotary <input type="checkbox"/> Driven <input type="checkbox"/> Dug <input type="checkbox"/> Hollow rod <input type="checkbox"/> Jetted <input type="checkbox"/> Bored <input type="checkbox"/> Reverse rotary		
				6 Use: <input type="checkbox"/> Domestic <input type="checkbox"/> Public supply <input type="checkbox"/> Industry <input checked="" type="checkbox"/> Irrigation <input type="checkbox"/> Air conditioning <input type="checkbox"/> Commercial <input type="checkbox"/> Test well		
				7 Casing: Material <b>steel</b> Height: above/below Threaded <input type="checkbox"/> Welded <input checked="" type="checkbox"/> Surface <b>12</b> in. Diam. Weight <b>333</b> lbs./ft. <b>16</b> in. to <b>529</b> ft. depth Drive shoe? <input type="checkbox"/> Yes <input checked="" type="checkbox"/> No		
				8 Screen: Manufacturer <b>Mill Slot</b> Type <b>6%</b> Dia. <b>16"</b> Slot/gauze <b>1/8</b> Length <b>2"</b> Set between <del>90</del> ft. and <del>90</del> ft. Fittings: <b>760-320 + 460-529</b> Gravel pack <input checked="" type="checkbox"/> Yes <input type="checkbox"/> No Size range of material <b>1/2"</b>		
				9 Static water level: <b>210</b> ft. below land surface Date <b>3-15-75</b>		
				10 Pumping level below land surfaces: <b>230</b> ft. after <b>4</b> hrs. pumping <b>1200</b> g.p.m. ____ ft. after ____ hrs. pumping ____ g.p.m. Estimated maximum yield <b>3000</b> g.p.m.		
				11 Water sample submitted: <input type="checkbox"/> Yes <input checked="" type="checkbox"/> No Date _____		
				12 Well head completion: <input type="checkbox"/> Pitless adapter <input checked="" type="checkbox"/> Inches above grade		
				13 Well grouted? <input checked="" type="checkbox"/> Yes <input type="checkbox"/> No <input checked="" type="checkbox"/> Neat cement <input type="checkbox"/> Bentonite <input type="checkbox"/> _____ Depth: From <b>0</b> ft. to <b>10</b> ft.		
				14 Nearest source of possible contamination: <b>NA</b> ft. _____ Direction _____ Type _____ Well disinfected upon completion? <input type="checkbox"/> Yes <input type="checkbox"/> No		
				15 Pump: <input type="checkbox"/> Not installed Manufacturer's name <b>Worthington</b> Model number <b>15H226</b> HP _____ Volts _____ Length of drop pipe <del>300</del> ft. capacity <del>200</del> g.p.m. Type: <b>360</b> <b>2250</b> <input type="checkbox"/> Submersible <input checked="" type="checkbox"/> Turbine <input type="checkbox"/> Jet <input type="checkbox"/> Reciprocating <input type="checkbox"/> Centrifugal <input type="checkbox"/> Other		
				17 Water well contractor's certification: This well was drilled under my jurisdiction and this report is true to the best of my knowledge and belief. <b>High Plains Drilling &amp; Supply, Inc.</b> Business name <b>402 N 3rd, Garden City, Ks 136</b> License No. Address Signed <b>[Signature]</b> Date <b>4-15-75</b> Authorized representative		