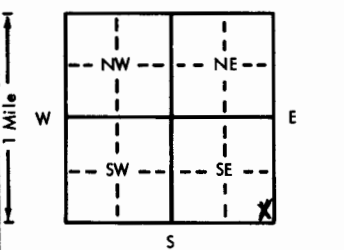


County <b>Grant</b>		Fraction <b>SE 1/4 SE 1/4 SE 1/4</b>	Section number <b>11</b>	Township number <b>T 27 S R 38 E/W</b>
1. Location of well: <b>Grant</b>			2. Distance and direction from nearest town or city: <b>9 miles north,</b> <b>2/10 West of Ulysses, Kansas</b>	
3. Owner of well: <b>Ralph Frazee</b> R.R. or street: <b>Ulysses, Ks. 67880</b> City, state, zip code:			4. Locate with "X" in section below: <div style="text-align: center;"></div>	
5. Type and color of material			From	To
Surface			0	2
Very fine sand & clay breakers			2	27
Brown clay			27	77
Blue clay			77	169
Brown clay			169	210
Medium to coarse sand w/clay breakers			210	283
Brown shale w/very fine sand.			283	345
Brown shale, Dakota & sandrock			345	385
Brown shale,			385	421
18. Elevation:			19. Remarks: <b>Pits are to be backfilled as soon as milo is out of field. This will complete the well.</b>	
Topography: <input type="checkbox"/> Hill <input checked="" type="checkbox"/> Slope <input type="checkbox"/> Upland <input type="checkbox"/> Valley			20. Water well contractor's certification: This well was drilled under my jurisdiction and this report is true to the best of my knowledge and belief. <b>Houck Bros. Drig. Co.</b> Business name: <b>Ulysses, Ks. Box 487</b> Address: <b>M. Beard</b> Signed: <b>M. Beard</b> Date: <b>4/1/76</b> Authorized representative	