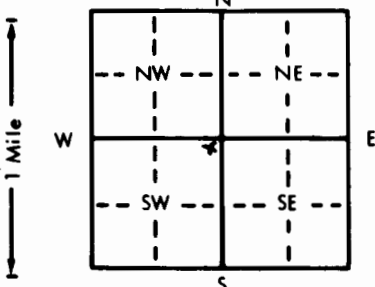


1 LOCATION OF WATER WELL: County: Grant Fraction NE 1/4 NE 1/4 SW 1/4 Section Number 23 Township Number T 27 S Range Number R 38 EW

Distance and direction from nearest town or city street address of well if located within city?
7 miles north, 4 1/2 miles west of Ulysses, Ks.

2 WATER WELL OWNER: Leonard Hohner
RR#, St. Address, Box #: 111 N. College Board of Agriculture, Division of Water Resources
City, State, ZIP Code: Ulysses, Ks. 67880 Application Number: vested right GT012

3 LOCATE WELL'S LOCATION WITH AN "X" IN SECTION BOX: 

4 DEPTH OF COMPLETED WELL: 610.3 ft. ELEVATION: slope
Depth(s) Groundwater Encountered 1. 200 ft. 2. ft. 3. ft.
WELL'S STATIC WATER LEVEL: 200 ft. below land surface measured on mo/day/yr August 24, 1985
Pump test data: Well water was ft. after hours pumping gpm
Est. Yield gpm: Well water was *NC* ft. after hours pumping gpm
Bore Hole Diameter: 26 in. to 610.3 ft., and in. to ft.
WELL WATER TO BE USED AS:
5 Public water supply 8 Air conditioning 11 Injection well
1 Domestic 3 Feedlot 6 Oil field water supply 9 Dewatering 12 Other (Specify below)
2 Irrigation 4 Industrial 7 Lawn and garden only 10 Observation well
Was a chemical/bacteriological sample submitted to Department? Yes No ; If yes, mo/day/yr sample was submitted
Water Well Disinfected? Yes No

5 TYPE OF BLANK CASING USED:
1 Steel 3 RMP (SR) 5 Wrought iron 8 Concrete tile CASING JOINTS: Glued Clamped
2 PVC 4 ABS 6 Asbestos-Cement 9 Other (specify below) Welded
7 Fiberglass Threaded
Blank casing diameter 16 in. to 311.3 ft., Dia 16 in. to 510 ft., Dia in. to ft.
Casing height above land surface 18 in., weight 42.05 lbs./ft. Wall thickness or gauge No. 250
TYPE OF SCREEN OR PERFORATION MATERIAL:
1 Steel 3 Stainless steel 5 Fiberglass 7 PVC 10 Asbestos-cement
2 Brass 4 Galvanized steel 6 Concrete tile 8 RMP (SR) 11 Other (specify)
9 ABS 12 None used (open hole)
SCREEN OR PERFORATION OPENINGS ARE:
1 Continuous slot 3 Mill slot 5 Gauzed wrapped 8 Saw cut 11 None (open hole)
2 Louvered shutter 4 Key punched 6 Wire wrapped 9 Drilled holes
7 Torch cut 10 Other (specify)
SCREEN-PERFORATED INTERVALS: From 311.3 ft. to 432.3 ft., From ft. to ft.
From 510.3 ft. to 610.3 ft., From ft. to ft.
GRAVEL PACK INTERVALS: From 10 ft. to 610.3 ft., From ft. to ft.
From ft. to ft., From ft. to ft.

6 GROUT MATERIAL: 1 Neat cement 2 Cement grout 3 Bentonite 4 Other
Grout intervals: From 0 ft. to 10 ft., From ft. to ft., From ft. to ft.
What is the nearest source of possible contamination:
1 Septic tank 4 Lateral lines 7 Pit privy 10 Livestock pens 14 Abandoned water well
2 Sewer lines 5 Cess pool 8 Sewage lagoon 11 Fuel storage 15 Oil well/Gas well
3 Watertight sewer lines 6 Seepage pit 9 Feedyard 12 Fertilizer storage 16 Other (specify below)
13 Insecticide storage
Direction from well? about 300 feet west of this well How many feet?

FROM	TO	LITHOLOGIC LOG	FROM	TO	LITHOLOGIC LOG
0	2	Surface			
2	80	Clay and sandy clay			
80	120	Clay			
120	160	Clay w/fine sand strips			
160	190	Clay			
190	230	Fine to coarse sand			
230	290	Clay /fine to medium sand strips			
290	320	Clay			
320	345	Clay, yellow chalk & sandstone	10%		
345	420	Sandstone	75%		
420	440	Blue shale and sandstone	25%		
440	510	Blue shale			
510	540	Blue shale and sandstone	25%		
540	612	Blue shale and sandstone	65%		

7 CONTRACTOR'S OR LANDOWNER'S CERTIFICATION: This water well was (1) constructed, (2) reconstructed, or (3) plugged under my jurisdiction and was completed on (mo/day/year) August 24, 1985 and this record is true to the best of my knowledge and belief. Kansas Water Well Contractor's License No. 64 This Water Well Record was completed on (mo/day/yr) September 25, 1985 under the business name of HOUCK BROS. DRILLING CO. by (signature) *Mollie M. Beard*

INSTRUCTIONS: Use typewriter or ball point pen, PLEASE PRESS FIRMLY and PRINT clearly. Please fill in blanks, underline or circle the correct answers. Send top three copies to Kansas Department of Health and Environment, Division of Environment, Environmental Geology Section, Topeka, KS 66620. Send one to WATER WELL OWNER and retain one for your records.

OFFICE USE ONLY

T

R

EW

SEC

1/4

1/4

1/4