


LOCATION OF WATER WELL: Fraction | Section Number | Township Number | Range Number  
 COUNTY: GRANT | NW 1/4 NW 1/4 SE 1/4 | 19 | T 27 S | R 38 W

Distance and direction from nearest town or city street address of well if located within city?  
 4WAY STOP ULYSSES - 7 NORTH TO HITCH RD - 81/2W & 1/8NORTH

WATER WELL OWNER: ANNIS, ROBERT  
 RR#, St. Address, Box #: 9474 W. ROAD 5 Board of Agriculture, Division of Water Resources  
 City, State, ZIP code: ULYSSES, KS 67880- Application Number:

LOCATE WELL'S LOCATION WITH AN "X" IN SECTION BOX: 4 DEPTH OF COMPLETED WELL 625 ELEVATION: 0  
 Depth(s) Groundwater Encountered 1. 0 ft. 2. 0 ft. 3. 0 ft.

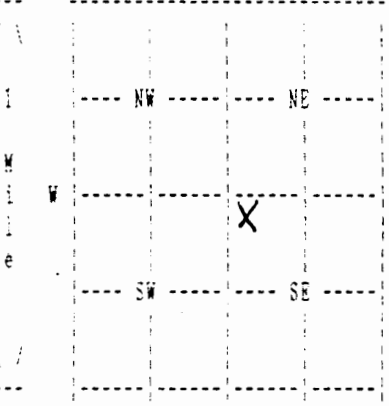

WELL'S STATIC WATER LEVEL 258 ft. below land surface measured on mo/day/yr 01/09/05  
 Pump test data: Well water was 0 ft. after 0 hours pumping 0 gpm  
 Estimated Yield 40 gpm: Well water was 0 ft. after 0 hours pumping 0 gpm  
 Bore Hole Diameter 10 in. to 625 ft., and in. to 0 ft.  
 WELL WATER TO BE USED AS: DOMESTIC  
 Was a chemical/bacteriological sample submitted to department? No ;  
 If yes, mo/day/yr sample was submitted Water well disinfected? Yes

TYPE OF BLANK CASING USED: CERTA LOC CASIN CASING JOINTS: CERTA-LOC  
 Blank casing diameter 5 in. to 625 ft., Dia in. to 0 ft., Dia in. to 0 ft.  
 Casing height above land surface 12 in., weight 200 lbs/ft. Wall thickness or gauge No. 17  
 TYPE OF SCREEN OR PERFORATION MATERIAL: PVC  
 SCREEN OR PERFORATION OPENINGS ARE: SAW CUT

SCREEN PERFORATED INTERVALS: From 415 ft. to 455 ft., From 575 ft. to 615 ft.  
 From 515 ft. to 555 ft., From 0 ft. to 0 ft.  
 GRAVEL PACK INTERVALS: From 28 ft. to 625 ft., From 0 ft. to 0 ft.  
 From 0 ft. to 0 ft., From 0 ft. to 0 ft.

GROUT MATERIAL BENTONITE  
 Grout Intervals: From 5 ft. to 28 ft., From 0 ft. to 0 ft., From 0 ft. to 0 ft.  
 What is the nearest source of possible contamination: NONE  
 Direction from well? How many feet? 0

FROM	TO	LITHOLOGIC LOG	FROM	TO	PLUGGING INTERVALS
0	2	01 TOPSOIL			
2	18	11 BROWN CLAY			
18	37	10 FINE-MEDSAND			
37	57	10 FINE-MEDSAND 09 GRAVEL			
57	113	11 BROWN CLAY			
113	122	10 FINE-MEDSAND 09 GRAVEL			
122	141	11 BROWN CLAY			
141	154	10 FINE-MEDSAND 09 GRAVEL			
154	212	11 BROWN CLAY 30 SANDY			
212	233	10 FINE-MEDSAND 09 GRAVEL			

CONTRACTOR'S OR LANDOWNER'S CERTIFICATION: This water well was Constructed under my jurisdiction and was completed on (mo/day/year) 01/10/05 and this record is true to the best of my knowledge and belief. Kansas Water Well Contractor's License No. 179 This Water Well Record was completed on (mo/day/yr) 02/07/05 under the business name of JOB'S WELL SERVICE, INC. by (signature) *Josid Creek*

1 LOCATION OF WATER WELL:      Fraction      Section Number      Township Number      Range Number  
 COUNTY: GRANT      NW 1/4 NW 1/4 SE 1/4      19      T 27 S      R 38 W

2 WATER WELL OWNER:      ANNIS, ROBERT  
 RR#, St. Address, Box #: 9474 W. ROAD 5      Board of Agriculture, Division of Water Resources  
 City, State, ZIP code : ULYSSES, KS 67880-      Application Number:

FROM	TO	LITHOLOGIC LOG
233	299	11 BROWN CLAY 30 SANDY
299	319	11 BROWN CLAY 30 SANDY 02 FINE SAND
319	357	11 BROWN CLAY 30 SANDY
357	363	11 BROWN CLAY 26 RED CLAY
363	368	25 YELLOW CLAY
368	537	31 SHALE
537	575	31 SHALE + 29 sandstone
575	600	29 SANDSTONE
600	645	31 SHALE (blue)
645	650	13 RED BED

7 CONTRACTOR'S OR LANDOWNER'S CERTIFICATION: This water well was Constructed under my jurisdiction and was completed on (mo/day/year) 01/10/05 and this record is true to the best of my knowledge and belief. Kansas Water Well Contractor's License No. 179      This Water Well Record was completed on (mo/day/yr) 02/07/05 under the business name of JOB'S WELL SERVICE, INC.      by (signature) *Quint Crick*