


1 LOCATION OF WATER WELL: Fraction NE 1/4 NE 1/4 NE 1/4 Section Number 15 Township Number T 27S S Range Number R 38W E/W
 County: Grant

Distance and direction from nearest town or city street address of well if located within city?
 From Ulysses: 7N, 5 W, W into

2 WATER WELL OWNER: Minter Wilson Ralph Ryder
 RR#, St. Address, Box # : W. Hwy #50 Board of Agriculture, Division of Water Resources
 City, State, ZIP Code : Garden City, Kans. 67846 Application Number:

3 LOCATE WELL'S LOCATION WITH AN "X" IN SECTION BOX:

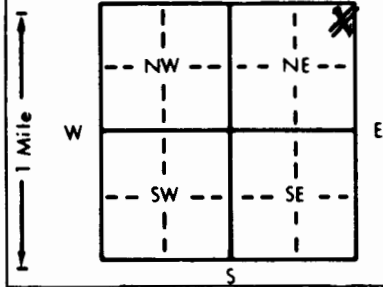

4 DEPTH OF COMPLETED WELL... 320' ft. ELEVATION:
 Depth(s) Groundwater Encountered 1. 195 ft. 2. ft. 3. ft.
 WELL'S STATIC WATER LEVEL... 195 ft. below land surface measured on mo/day/yr 08-09-94
 Pump test data: Well water was 281 ft. after 1 hours pumping 30 gpm
 Est. Yield 30 gpm: Well water was ft. after hours pumping gpm
 Bore Hole Diameter... 11 in. to 320 ft., and in. to ft.
 WELL WATER TO BE USED AS:
 1 Domestic 3 Feedlot 6 Oil field water supply 9 Dewatering 12 Other (Specify below)
 2 Irrigation 4 Industrial 7 Lawn and garden only 10 Monitoring well
 Was a chemical/bacteriological sample submitted to Department? Yes.....No X.....; If yes, mo/day/yr sample was submitted
 Water Well Disinfected? Yes X No

5 TYPE OF BLANK CASING USED:
 1 Steel 3 RMP (SR) 5 Wrought iron 8 Concrete tile CASING JOINTS: Glued X Clamped
 2 PVC 4 ABS 6 Asbestos-Cement 9 Other (specify below) Welded
 7 Fiberglass Threaded
 Blank casing diameter 5 in. to 320 ft., Dia in. to ft., Dia in. to ft.
 Casing height above land surface 24 in., weight 2,902 lbs./ft. Wall thickness or gauge No. 265 SDR 21

TYPE OF SCREEN OR PERFORATION MATERIAL:
 1 Steel 3 Stainless steel 5 Fiberglass 7 PVC 10 Asbestos-cement
 2 Brass 4 Galvanized steel 6 Concrete tile 9 ABS 11 Other (specify)
 12 None used (open hole)

SCREEN OR PERFORATION OPENINGS ARE:
 1 Continuous slot 3 Mill slot 5 Gauzed wrapped 8 Saw cut 11 None (open hole)
 2 Louvered shutter 4 Key punched 6 Wire wrapped 9 Drilled holes
 7 Torch cut 10 Other (specify)

SCREEN-PERFORATED INTERVALS: From 220 ft. to 320 ft., From ft. to ft.
 From ft. to ft., From ft. to ft.
 GRAVEL PACK INTERVALS: From 180 ft. to 320 ft., From ft. to ft.
 From ft. to ft., From ft. to ft.

6 GROUT MATERIAL: 1 Heat cement 2 Cement grout 3 Bentonite 4 Other HOLE PLUG
 Grout Intervals: From 1 ft. to 20 ft., From ft. to ft., From ft. to ft.

What is the nearest source of possible contamination:
 1 Septic tank 4 Lateral lines 7 Pit privy 10 Livestock pens 14 Abandoned water well
 2 Sewer lines 5 Cess pool 8 Sewage lagoon 11 Fuel storage 15 Oil well/Gas well
 3 Watertight sewer lines 6 Seepage pit 9 Feedyard 12 Fertilizer storage 16 Other (specify below)
 13 Insecticide storage

Direction from well? How many feet?

FROM	TO	LITHOLOGIC LOG	FROM	TO	PLUGGING INTERVALS
0	2	CLAY	242	249	FINE SAND
2	15	CLAY	249	254	SAND STONE
15	25	CALICHE	254	262	SAND
25	47	SAND & CLAY	262	278	CLAY & SAND STONE
47	81	CLAY	278	285	FINE SAND
81	105	SMALL GRAVEL	285	293	SAND STONE
105	114	CLAY	293	320	BLUE SHALE
114	124	SANDY CLAY			
124	142	SAND & CALICHE			
142	152	SANDY CLAY & CLAY			
152	165	CLAY & GRAVEL MIX			
165	173	BLACK CLAY			
173	182	SANDY CLAY			
182	237	SANDY CLAY & BLUE CLAY			
237	242	SANDY CLAY			

7 CONTRACTOR'S OR LANDOWNER'S CERTIFICATION: This water well was (1) constructed, (2) reconstructed, or (3) plugged under my jurisdiction and was completed on (mo/day/year) 8-9-94 and this record is true to the best of my knowledge and belief. Kansas Water Well Contractor's License No. KWWCL-430 This Water Well Record was completed on (mo/day/yr) 8-9-94 under the business name of HOWARD DRUG CO. BOX 806 BEAVER, OK 73932 by (signature) Howard

INSTRUCTIONS: Use typewriter or ball point pen. PLEASE PRESS FIRMLY and PRINT clearly. Please fill in blanks, underline or circle the correct answers. Send top three copies to Kansas Department of Health and Environment, Bureau of Water, Topeka, Kansas 66620-0001. Telephone: 913-296-5545. Send one to WATER WELL OWNER and retain one for your records.