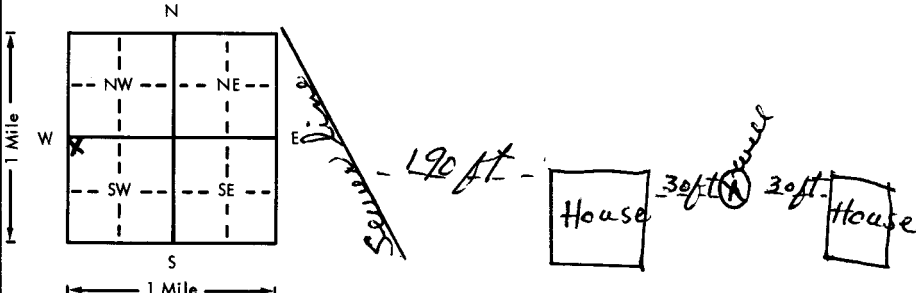


USE TYPEWRITER OR BALL
POINT PEN-PRESS FIRMLY,
PRINT CLEARLY.

WATER WELL RECORD
KSA 82a-1201-1215

Kansas Department of Health and
Environment-Division of Environment
(Water well Contractors)
Topeka, Kansas 66620

1. Location of well:		County Stanton	Fraction NW 1/4 NW 1/4 SW 1/4	Section number 13	Township number T 27 S	Range number R 39 E
2. Distance and direction from nearest town or city: from Standard Service Station at Ulysses 11 miles west, Street address of well location if in city: 8 north, 1 east, 1/2 North			3. Owner of well: Wayne Snell R.R. or street: RFD 1 City, state, zip code: Johnson, Ks. 67855			
4. Locate with "X" in section below: 			6. Bore hole dia. 9 3/4 in. Completion date _____ Well depth 300 ft. 8-17-77			
			7. <input checked="" type="checkbox"/> Cable tool <input checked="" type="checkbox"/> Rotary <input type="checkbox"/> Driven <input type="checkbox"/> Dug <input type="checkbox"/> Hollow rod <input type="checkbox"/> Jetted <input type="checkbox"/> Bored <input type="checkbox"/> Reverse rotary			
			8. Use: <input checked="" type="checkbox"/> Domestic <input type="checkbox"/> Public supply <input type="checkbox"/> Industry <input type="checkbox"/> Irrigation <input type="checkbox"/> Air conditioning <input type="checkbox"/> Stock <input type="checkbox"/> Lawn <input type="checkbox"/> Oil field water <input type="checkbox"/> Other			
			9. Casing: Material styrene Height: 24 in. Above or below Threaded glued Surface 24 in. in. RMP PVC Weight _____ lbs./ft. Dia. 5 in. to 200 ft. depth Wall thickness _____ inches or Dia. _____ in. to _____ ft. depth gage No. .320			
5. Type and color of material			From	To	10. Screen: Manufacturer's name Sunflower Type styrene Dia. 5" Slot/gauze 1/16" Length 100 Set between 200 ft. and 300 ft. _____ ft. and _____ ft. Gravel pack? <input checked="" type="checkbox"/> Size range of material 1/4 x 5/8"	
Surface			0	2	11. Static water level: _____ mo./day/yr. 180 ft. below land surface Date 8-5-77	
Clay			2	18	12. Pumping level below land surfaces: 191 ft. after 3 hrs. pumping 25 g.p.m. _____ ft. after _____ hrs. pumping _____ g.p.m. Estimated maximum yield _____ g.p.m.	
Fine to medium sand w/clay strips			18	145	13. Water sample submitted: _____ mo./day/yr. Yes <input type="checkbox"/> No <input checked="" type="checkbox"/> Date _____	
Yellow chalk & clay			145	180	14. Well head completion: <input checked="" type="checkbox"/> Pitless adapter 24 inches above grade	
Sandstone & clay			180	240	15. Well grouted? <input checked="" type="checkbox"/> With: <input checked="" type="checkbox"/> Neat cement _____ Bentonite _____ Concrete _____ Depth: From 0 ft. to 10 ft.	
Sandstone & blue shale			240	300	16. Nearest source of possible contamination: sewer ft. 100 Direction west Type line Well disinfected upon completion? <input checked="" type="checkbox"/> Yes _____ No _____	
					17. Pump: <input checked="" type="checkbox"/> Not installed Manufacturer's name _____ Model number _____ HP _____ Volts _____ Length of drop pipe _____ ft. capacity _____ g.p.m. Type: <input type="checkbox"/> Submersible <input type="checkbox"/> Turbine <input type="checkbox"/> Jet <input type="checkbox"/> Reciprocating <input type="checkbox"/> Centrifugal <input type="checkbox"/> Other	
					18. Elevation:	
					19. Remarks:	
					20. Water well contractor's certification: This well was drilled under my jurisdiction and this report is true to the best of my knowledge and belief. Houck Bros. Drlg. Co. 164 Business name _____ License No. _____ Address Box 487, Ulysses, Ks Signed M. Beard Date 9/21/77 Authorized representative	

27 39 0 13
1/4 1/4 2/4
Sec