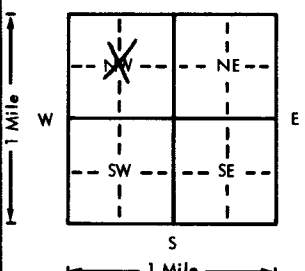


USE TYPEWRITER OR BALL
POINT PEN-PRESS FIRMLY,
PRINT CLEARLY.

WATER WELL RECORD
KSA 82a-1201-1215

Kansas Department of Health and
Environment-Division of Environment
(Water well Contractors)
Topeka, Kansas 66620

1. Location of well:		County <u>Stanton</u>	Fraction <u>se 1/4 NW 1/4 NW 1/4</u>	Section number <u>26</u>	Township number <u>T 27 S</u>	Range number <u>R 39 E/W</u>
2. Distance and direction from nearest town or city: <u>6 1/2 miles north of Big Bow, 1/2 mile east</u> Street address of well location if in city:			3. Owner of well: <u>Raymond Molz</u> R.R. or street: <u>RFD 1</u> City, state, zip code: <u>Johnson, Ks 67855</u>			
4. Locate with "X" in section below: N W E S 1 Mile 1 Mile			Sketch map: 		6. Bore hole dia. <u>26</u> in. Completion date <u>2-29-76</u> Well depth <u>380</u> ft.	
5. Type and color of material			From		To	
7. <input type="checkbox"/> Cable tool <input type="checkbox"/> Rotary <input type="checkbox"/> Driven <input type="checkbox"/> Dug <input type="checkbox"/> Hollow rod <input type="checkbox"/> Jetted <input type="checkbox"/> Bored <input checked="" type="checkbox"/> Reverse rotary			8. Use: <input type="checkbox"/> Domestic <input type="checkbox"/> Public supply <input type="checkbox"/> Industry <input checked="" type="checkbox"/> Irrigation <input type="checkbox"/> Air conditioning <input type="checkbox"/> Stock <input type="checkbox"/> Lawn <input type="checkbox"/> Oil field water <input type="checkbox"/> Other			
9. Casing: Material <u>Steel</u> Height: Above or below Threaded <input type="checkbox"/> Welded <input checked="" type="checkbox"/> Surface <u>12</u> in. RMP <input type="checkbox"/> PVC <input type="checkbox"/> Weight <u>36.87</u> lbs./ft. Dia. <u>16</u> in. to <u>38 1/2</u> ft. 30 ft. Wall Thickness: inches or Dia. <u>16</u> in. to <u>38 1/2</u> ft. depth gauge No. <u>219</u>			10. Screen: Manufacturer's name <u>Johnson Division</u> Type <u>Galv</u> Dia. <u>16"</u> Slot/gauze <u>100</u> Length <u>20'</u> Set between <u>238-248</u> ft. and <u>350-370</u> ft. Perf <u>290-350</u> ft. and <u>370-380</u> ft. Gravel pack? <u>yes</u> Size range of material <u>1/2" Down</u>			
11. Static water level: <u>160</u> ft. below land surface Date <u>1-10-76</u> mo./day/yr.			12. Pumping level below land surfaces: <u>160</u> ft. after <u>0</u> hrs. pumping <u>0</u> g.p.m. <u>0</u> ft. after <u>0</u> hrs. pumping <u>0</u> g.p.m. Estimated maximum yield <u>0</u> g.p.m.			
13. Water sample submitted: <u>Yes</u> <u>No</u> Date <u>1-10-76</u> mo./day/yr.			14. Well head completion: <input checked="" type="checkbox"/> Pitless adapter <u>0</u> inches above grade			
15. Well grouted? <u>yes</u> With: <input checked="" type="checkbox"/> Neat cement <input type="checkbox"/> Bentonite <input type="checkbox"/> Concrete Depth: From <u>0</u> ft. to <u>10</u> ft.			16. Nearest source of possible contamination: ft. <u>0</u> Direction <u>None</u> Type <u>None</u> Well disinfected upon completion? <u>Yes</u> <u>No</u>			
17. Pump: <input checked="" type="checkbox"/> Not installed Manufacturer's name <u>0</u> Model number <u>0</u> HP <u>0</u> Volts <u>0</u> Length of drop pipe <u>0</u> ft. capacity <u>0</u> g.p.m. Type: <input type="checkbox"/> Submersible <input type="checkbox"/> Turbine <input type="checkbox"/> Jet <input type="checkbox"/> Reciprocating <input type="checkbox"/> Centrifugal <input type="checkbox"/> Other			20. Water well contractor's certification: This well was drilled under my jurisdiction and this report is true to the best of my knowledge and belief. <u>Winton Wilton Drilling 208</u> Business name License No. <u>0</u> Address <u>P.O. Box A Garden City, Ks</u> Signed <u>Winton Wilton</u> Date <u>7-16-76</u> Authorized representative			
18. Elevation:		19. Remarks: <u>Pump not installed</u>				
Topography: <input type="checkbox"/> Hill <input checked="" type="checkbox"/> Slope <input type="checkbox"/> Upland <input type="checkbox"/> Valley						

Phone 276-8269 • P.O. Box 493 • GARDEN CITY, KANSAS 67846

RAYMOND MOLZ
Stanton County
1-10-75

Location: NW 26-27-39
60 feet west of Test # 10

Test #. 11

0	1	Top Soil
1	50	Brown Clay
50	64	Fine to Med. Sand & Fine Gravel (Loose)
64	112	Brown Clay
112	155	Brown & Gray Clay
155	188	Blue Clay
188	223	Brown Clay
223	243	Fine to Med. Sand & Gravel (Loose)
243	248	Fine to Med. Sand & Gravel (Tight)(Hard Streaks)
248	290	Brown Clay
290	305	Fine to Med. Sand & Gravel, 20% Clay (Loose)
305	321	Fine to Med. Sand & Gravel, 15% Clay (Loose)
321	335	Fine to Med. Sand & Gravel, 35% Clay (Loose)
335	350	Fine to Med. Sand & Gravel, 15% Clay (Loose)
350	370	Fine to Med. Sand & Gravel (Loose)
370	391	Brown, Gray & Yellow Clay with Brown Rock(Tight)
391	395	Shale (hard)

T.D. - 380'