


USE TYPEWRITER OR BALL POINT PEN-PRESS FIRMLY, PRINT CLEARLY.

WATER WELL RECORD
KSA 82a-1201-1215

Kansas Department of Health and Environment-Division of Environment
(Water well Contractors)
Topeka, Kansas 66620

1. Location of well: County **Stanton** Fraction **SE 1/4 SE 1/4 NW 1/4** Section number **36** Township number **T 27 S R 39 E/W**

2. Distance and direction from nearest town or city: **6 miles north, 1 east, 1/2 north, 1/2 east of Big Bow, Ks.**
Street address of well location if in city:
3. Owner of well: **Robert Seger**
R.R. or street: **Ulysses, Ks. 67880**
City, state, zip code:

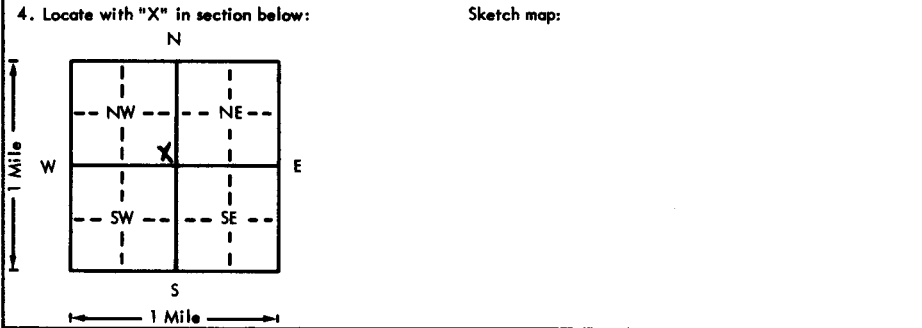

6. Bore hole dia. 27 in. Completion date _____
Well depth 566.6 ft. *See Remarks:*

7. Cable tool Rotary Driven Dug
 Hollow rod Jetted Bored Reverse rotary

8. Use: Domestic Public supply Industry
 Irrigation Air conditioning Stock
 Lawn Oil field water Other

9. Casing: Material steel Height Above or below
Threaded Welded Surface 14 in.
RMP PVC Weight 36.8 lbs./ft.
Dia. 16 in. to 285.10 ft. depth Wall Thickness: inches or
Dia. _____ in. to _____ ft. depth gage No. 219

5. Type and color of material	From	To
Surface	0	2
Very fine sand & clay	2	10
Brown sandy clay	10	187
Medium to coarse sand w/clay breakers	187	222
Cemented sand & clay	222	226
Sandy clay w/very fine to fine sand	226	339
Medium to coarse sand w/sandrock & clay	339	370
Sandrock, brown shale & yellow chalke	370	391
Brown -shale, yellow chalk, sandrock & Dakota	391	404
Blue & brown shale & Dakota	404	480
Brown & blue shale, white clay & Dakota	480	519
Brown & blue shale, Kakota & Cheyenne	519	552
Rock	552	566

10. Screen: Manufacturer's name Lakewood
Pipe of Texas
Type steel Dia. 16"
Slot/gauze 3/16 Length 280.8'
Set between 285.10 ft. and 566.6 ft.
Gravel pack? Size range of material 1/4 x 5/8"

11. Static water level: _____ mo./day/yr.
235 ft. below land surface Date 6-29-76

12. Pumping level below land surfaces:
349 ft. after 43.2 hrs. pumping 1050 g.p.m.
_____ ft. after _____ hrs. pumping _____ g.p.m.
Estimated maximum yield _____ 1200 g.p.m.

13. Water sample submitted: _____ mo./day/yr.
Yes No Date _____

14. Well head completion: NA
_____ Pitless adapter _____ Inches above grade

15. Well grouted? X
With: _____ Neat cement X _____ Bentonite _____ Concrete
Depth: From 0 ft. to 10 ft.

16. Nearest source of possible contamination: NA
_____ Direction _____ Type _____
Well disinfected upon completion? _____ Yes No

17. Pump: X Not installed
Manufacturer's name _____
Model number _____ HP _____ Volts _____
Length of drop pipe _____ ft. capacity _____ g.p.m.
Type:
 Submersible Turbine
 Jet Reciprocating
 Centrifugal Other

18. Elevation: Topography: _____ Hill X Slope _____ Upland _____ Valley

19. Remarks: **This well was paid for July 30, 1976
The pits have not been backfilled yet.**

20. Water well contractor's certification:
This well was drilled under my jurisdiction and this report is true to the best of my knowledge and belief.
Houck Bros. Drlg. Co. 164
Business name Box 487, Ulysses, Mo. License No. _____
Address _____
Signed M. Beard Date 11/3/76
Authorized representative

27
39
E
36
S
E
E
W
1/4
1/4
1/4
1/4