


USE TYPEWRITER OR BALL POINT PEN—PRESS FIRMLY, PRINT CLEARLY.

WATER WELL RECORD  
KSA 82a-1201-1215

Kansas Department of Health and Environment—Division of Environment (Water well Contractors)  
Topeka, Kansas 66620

1. Location of well:	County <b>Stanton</b>	Fraction <b>SE 1/4 NW 1/4 SE 1/4</b>	Section number <b>36</b>	Township number <b>T 27 S R 39 E/W</b>	Range number <b>39</b>
----------------------	--------------------------	---	-----------------------------	---	---------------------------

2. Distance and direction from nearest town or city: <b>8 miles west, 5 north, 1 west of Standard Station, Ulysses, Kansas</b> <small>Street address of well location if in city:</small>	3. Owner of well: <b>Allen Williams</b> R.R. or street: <b>RFD</b> City, state, zip code: <b>Ulysses, Kansas 67880</b>
--	--

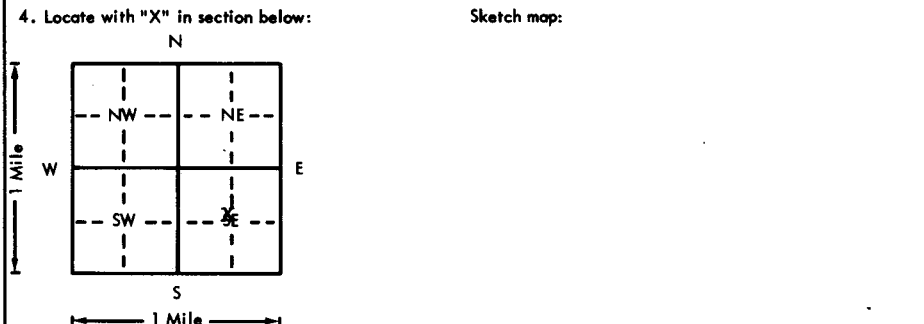

6. Bore hole dia. <u>2 1/2</u> in. Completion date _____ Well depth <u>611.6</u> ft. <u>4-3-76</u>
7. <input type="checkbox"/> Cable tool <input checked="" type="checkbox"/> Rotary <input type="checkbox"/> Driven <input type="checkbox"/> Dug <input type="checkbox"/> Hollow rod <input type="checkbox"/> Jetted <input type="checkbox"/> Bored <input type="checkbox"/> Reverse rotary
8. Use: <input type="checkbox"/> Domestic <input type="checkbox"/> Public supply <input type="checkbox"/> Industry <input checked="" type="checkbox"/> Irrigation <input type="checkbox"/> Air conditioning <input type="checkbox"/> Stock <input type="checkbox"/> Lawn <input type="checkbox"/> Oil field water <input type="checkbox"/> Other
9. Casing: Material <u>steel</u> Height <u>Above</u> or below Threaded <input type="checkbox"/> Welded <input checked="" type="checkbox"/> Surface <u>12</u> in. RMP _____ PVC _____ Weight <u>42.5</u> lbs./ft. Dia. <u>16</u> in. to <u>251.3</u> ft. depth Well Thickness: inches or Dia. _____ in. to _____ ft. depth gage No. <u>250</u>

5. Type and color of material	From	To
Surface	0	2
Brown sandy clay w/fine sand strips	2	133
Gray & brown clay	133	180
Brown sandy clay	180	226
Medium to coarse sand w/clay breakers	226	274
Sandy, gummy clay w/fine sand strips	274	381
Medium to coarse sand & sandrock w/brown shale	381	392
Yellow chale, brown shale, sandrock & Dakota	392	415
Yellow chalk, blue shale tight	415	426
Blue shale, yellow chalk and Dakota	426	529
Blue shale, Dakota & Cheyenne	529	612
(Use a second sheet if needed)		

10. Screen: Manufacturer's name <u>Lakewood</u> <u>Pipe and screen</u> Type <u>steel</u> Dia. <u>16"</u> Slot/gauze <u>3/16</u> Length <u>360.3'</u> Set between <u>251.3</u> ft. and <u>611.6</u> ft. Gravel pack? <input checked="" type="checkbox"/> Size range of material <u>1/2 x 5/8</u>
11. Static water level: _____ mo./day/yr. <u>187</u> ft. below land surface Date <u>2/13/76</u>
12. Pumping level below land surfaces: _____ ft. after _____ hrs. pumping _____ g.p.m. <u>236</u> ft. after <u>12.2</u> hrs. pumping <u>1390</u> g.p.m. Estimated maximum yield _____ g.p.m.
13. Water sample submitted: _____ mo./day/yr. Yes <input checked="" type="checkbox"/> No _____ Date _____
14. Well head completion: <input type="checkbox"/> Pitless adapter _____ <u>12</u> Inches above grade
15. Well grouted? <input checked="" type="checkbox"/> With: <input type="checkbox"/> Neat cement <input checked="" type="checkbox"/> Bentonite _____ Concrete _____ Depth: From <u>0</u> ft. to <u>10</u> ft.
16. Nearest source of possible contamination: ft. _____ Direction _____ Type <u>NA</u> Well disinfected upon completion? _____ Yes _____ No
17. Pump: <input checked="" type="checkbox"/> Not installed Manufacturer's name _____ Model number _____ HP _____ Volts _____ Length of drop pipe _____ ft. capacity _____ g.p.m. Type: <input type="checkbox"/> Submersible _____ Turbine _____ <input type="checkbox"/> Jet _____ Reciprocating _____ <input type="checkbox"/> Centrifugal _____ Other _____

18. Elevation:	19. Remarks:
Topography: <input type="checkbox"/> Hill <input checked="" type="checkbox"/> Slope <input type="checkbox"/> Upland <input type="checkbox"/> Valley	

20. Water well contractor's certification: This well was drilled under my jurisdiction and this report is true to the best of my knowledge and belief. <b>Houck Bros. Drlg. Co.</b> 16 Business name _____ License No. _____ Address <u>Box 487, Ulysses, Ks.</u> Signed <u>M. Beard</u> Date <u>4-30-76</u> Authorized representative
--

27  
 39  
 36  
 SE 1/4  
 1/4  
 1/4