

CORRECTION(S) TO WATER WELL RECORD (WWC-5)

(to rectify lacking or incorrect information)

County: Sedgwick

Location listed as:

Section-Township-Range: 25-4W-24S

Fraction ($\frac{1}{4}$ $\frac{1}{4}$ $\frac{1}{4}$): NE SE NE

Location changed to:

36-27S-4W

NE NE NE

Other changes: Initial statements: _____

Changed to: _____

Comments: _____

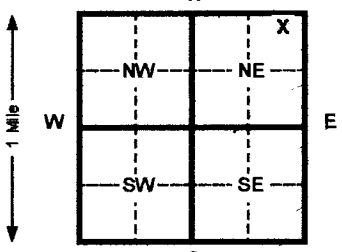
verification method: mapquest to find address

Garden Plain T.5 Quad to locate

initials: DL date: 6/10/03

submitted by: Kansas Geological Survey, Data Resources Library, 1930 Constant Ave., Lawrence, KS 66047-3726

to: Kansas Dept of Health & Environment, Bureau of Water, 1000 SW Jackson, Suite 420, Topeka, KS 66612-1367.

1 LOCATION OF WATER WELL:		Fraction	Section Number		Township Number		Range Number	
County: SEDGWICK		NE 1/4 SE 1/4 NE 1/4	25		T 4W S		R 27S E/W	
Distance and direction from nearest town or city street address of well if located within city?								
160 S EILEEN ST; GARDEN PLAIN, KS								
2 WATER WELL OWNER: LARRY UNDERHILL REALITY								
RR#, St. Address, Box # : 160 S EILEEN ST					Board of Agriculture, Division of Water Resources			
City, State, ZIP Code : GARDEN PLAIN, KS					Application Number:			
3 LOCATE WELL'S LOCATION WITH AN "X" IN SECTION BOX:		4 DEPTH OF COMPLETED WELL 72 ft. ELEVATION:						
		Depth(s) Groundwater Encountered 1 30 ft. 2 _____ ft. 3 _____ ft.						
		WELL'S STATIC WATER LEVEL 30 ft. below land surface measured on mo/day/yr 4/15/03						
		Pump test data: Well water was _____ ft. after _____ hours pumping _____ gpm						
		Est. Yield _____ gpm: Well water was _____ ft. after _____ hours pumping _____ gpm						
		Bore Hole Diameter 10 in. to 72 ft. and _____ in. to _____ ft.						
		WELL WATER TO BE USED AS: 5 Public water supply 8 Air conditioning 11 Injection well						
		1 Domestic 3 Feed lot 6 Oil field water supply 9 Dewatering 12 Other (Specify below)						
		2 Irrigation 4 Industrial 7 Lawn and garden (domestic) 10 Monitoring well						
		Was a chemical/bacteriological sample submitted to Department? Yes _____ No X If yes, mo/day/yr sample was submitted _____						
		Water Well Disinfected? Yes X No _____						
5 TYPE OF BLANK CASING USED:								
1 Steel			3 RMP (SR)			5 Wrought Iron		
2 PVC			4 ABS			8 Concrete tile		
			7 Fiberglass			CASING JOINTS: Glued X Clamped _____		
Blank casing diameter 5 in. to 72 ft., Dia _____ in. to _____ ft., Dia _____ in. to _____ ft.						Welded _____		
Casing height above land surface 16 in., weight 160 lbs./ft. Wall thickness or gauge No. 26						Threaded _____		
TYPE OF SCREEN OR PERFORATION MATERIAL:								
1 Steel			3 Stainless steel			7 PVC		
2 Brass			4 Galvanized steel			8 RMP (SR)		
			6 Concrete tile			9 ABS		
			5 Gauzed wrapped			10 Asbestos-cement		
SCREEN OR PERFORATION OPENINGS ARE:			8 Saw cut			11 Other (specify) _____		
1 Continuous slot			3 Mill slot			12 None used (open hole)		
2 Louvered shutter			4 Key punched			9 Drilled holes		
			7 Torch cut			10 Other (specify) _____		
SCREEN-PERFORATED INTERVALS: From 50 ft. to 72 ft. From _____ ft. to _____ ft.								
GRAVEL PACK INTERVALS: From 24 ft. to 72 ft. From _____ ft. to _____ ft.								
6 GROUT MATERIAL: 1 Neat cement 2 Cement grout 3 Bentonite 4 Other _____								
Grout Intervals From 4 ft. to 24 ft. From _____ ft. to _____ ft. From _____ ft. to _____ ft.								
What is the nearest source of possible contamination:								
1 Septic tank			4 Lateral lines			7 Pit privy		
2 Sewer lines			5 Cess pool			10 Livestock pens		
3 Watertight sewer lines			6 Seepage pit			11 Fuel storage		
			9 Feedyard			12 Fertilizer storage		
						13 Insecticide storage		
						14 Abandoned water well		
						15 Oil well/ Gas well		
						16 Other (specify below) _____		
Direction from well? WEST How many feet? 30								
FROM TO CODE LITHOLOGIC LOG FROM TO PLUGGING INTERVALS								
0 2 TOPSOIL								
2 17 CLAY								
17 38 MED SAND								
38 72 SHALE								
7 CONTRACTOR'S OR LANDOWNER'S CERTIFICATION: This water well was (1) constructed, (2) reconstructed, or (3) plugged under my jurisdiction and was completed on (mo/day/yr) 4/15/03 and this record is true to the best of my knowledge and belief. Kansas								
Water Well Contractor's License No. 611 This Water Well Record was completed on (mo/day/yr) 4/15/03								
under the business name of CHASE DRILLING by (signature) RICK CHASE								
INSTRUCTIONS: Please fill in blanks and circle the correct answers. Send three copies to Kansas Department of Health and Environment, Bureau of Water, 1000 S W Jackson St., Ste. 420, Topeka, Kansas 66612-1367. Telephone: 913-296-5545. Send one to WATER WELL OWNER and retain one for your records.								

OFFICE USE ONLY

1


SEC