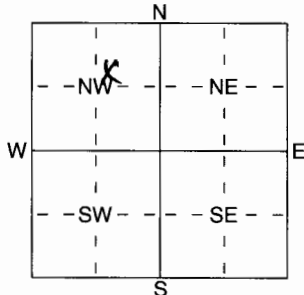


1 LOCATION OF WATER WELL:	Fraction	Section Number	Township Number	Range Number
County: <u>Sedgwick</u>	<u>SW</u> $\frac{1}{4}$ <u>NW</u> $\frac{1}{4}$ <u>NW</u> $\frac{1}{4}$	<u>20</u>	T <u>27S</u> S	R <u>46</u> E/W

Distance and direction from nearest town or city street address of well if located within city?

15051 S.E. 40th, Cheney2 WATER WELL OWNER: Scotty JergensonRR#, St. Address, Box # : 15051 S.E. 40th
City, State, ZIP Code : Cheney, KSBoard of Agriculture, Division of Water Resources
Application Number:3 LOCATE WELL'S LOCATION WITH 4 DEPTH OF COMPLETED WELL 55 ft. ELEVATION:

AN "X" IN SECTION BOX:

Depth(s) Groundwater Encountered 1 24 ft. 2 ft. 3 ft.WELL'S STATIC WATER LEVEL 24 ft. below land surface measured on mo/day/yr

Pump test data: Well water was ft. after hours pumping gpm

Est. Yield gpm: Well water was ft. after hours pumping gpm

WELL WATER TO BE USED AS: 5 Public water supply 8 Air conditioning 11 Injection well

1 Domestic 3 Feedlot 6 Oil field water supply 9 Dewatering 12 Other (Specify below)

2 Irrigation 4 Industrial Domestic (lawn & garden) 10 Monitoring wellWas a chemical/bacteriological sample submitted to Department? Yes No X If yes, mo/day/yr sample was submitted
Water Well Disinfected? Yes X No

5 TYPE OF BLANK CASING USED:

1 Steel 3 RMP (SR) 5 Wrought iron 8 Concrete tile CASING JOINTS: Glued X Clamped

2 PVC 4 ABS 6 Asbestos-Cement 9 Other (specify below) Welded

Blank casing diameter 5 in. to 55 ft. Dia in. to ft. DiaCasing height above land surface 16 in. weight 160 lbs./ft. Wall thickness or gauge No. 26

TYPE OF SCREEN OR PERFORATION MATERIAL:

1 Steel 3 Stainless Steel 5 Fiberglass 7 PVC 10 Asbestos-Cement

2 Brass 4 Galvanized Steel 6 Concrete tile 8 RMP (SR) 11 Other (Specify)

SCREEN OR PERFORATION OPENINGS ARE:

1 Continuous slot 3 Mill slot 5 Guazed wrapped 8 Saw cut 11 None (open hole)

2 Louvered shutter 4 Key punched 6 Wire wrapped 9 Drilled holes

7 Torch cut 10 Other (specify) ft.

SCREEN-PERFORATED INTERVALS: From 35 ft. to 55 ft. From ft. to ft.

From ft. to ft. From ft. to ft.

GRAVEL PACK INTERVALS: From 24 ft. to 55 ft. From ft. to ft.

From ft. to ft. From ft. to ft.

6 GROUT MATERIAL: 1 Neat cement 2 Cement grout 3 Bentonite 4 Other

Grout Intervals: From 4 ft. to 24 ft. From ft. to ft. From ft. to ft.

What is the nearest source of possible contamination:

1 Septic tank 4 Lateral lines 7 Pit privy 10 Livestock pens 14 Abandoned water well

2 Sewer lines 5 Cess pool 8 Sewage lagoon 11 Fuel storage 15 Oil well/Gas well

3 Watertight sewer lines 6 Seepage pit 9 Feedyard 12 Fertilizer storage 16 Other (specify below)

Direction from well? West How many feet? 200

FROM TO LITHOLOGIC LOG FROM TO PLUGGING INTERVALS

0 4 topsoil

4 17 red shale

17 21 green shale

21 29 red shale

29 36 blue shale

36 55 red shale

7 CONTRACTOR'S OR LANDOWNER'S CERTIFICATION: This water well was (1) constructed, (2) reconstructed, or (3) plugged under my jurisdiction and was completed on (mo/day/year) 2-25-05 and this record is true to the best of my knowledge and belief. KansasWater Well Contractor's Licence No cell This Water Well Record was completed on (mo/day/yr) 2-28-05under the business name of Chase Drilling by (signature) R. Chase