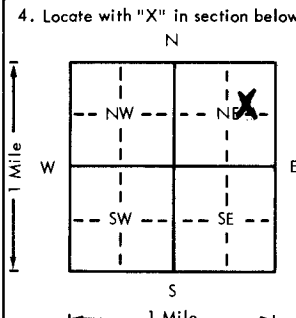


USE TYPEWRITER OR BALL
POINT PEN-PRESS FIRMLY,
PRINT CLEARLY.

WATER WELL RECORD
KSA 82a-1201-1215

Kansas Department of Health and
Environment-Division of Environment
(Water well Contractors)
Topeka, Kansas 66620

1. Location of well:		County: <u>Sedgwick</u>	Fraction: <u>SW 1/4 NE 1/4 NE 1/4</u>	Section number: <u>19</u>	Township number: <u>27</u> S <u>4</u> E <u>W</u>	Range number: <u>4</u>
2. Distance and direction from nearest town or city: <u>1/2 W. 3 1/2 Mo Cheney KS.</u>				3. Owner of well: <u>Fidelity Investment</u> R.R. or street: <u>229 So market</u> City, state, zip code: <u>Wichita KS</u>		
4. Locate with "X" in section below:		Sketch map:		6. Bore hole dia. <u>11</u> in. Completion date: <u>5/12/78</u> Well depth: <u>255</u> ft.		
				7. ☒ Cable tool ☒ Rotary ☐ Driven ☐ Dug ☐ Hollow rod ☐ Jetted ☐ Bored ☐ Reverse rotary		
5. Type and color of material		From		To		8. Use: ☒ Domestic ☐ Public supply ☐ Industry ☐ Irrigation ☐ Air conditioning ☐ Stock ☐ Lawn ☐ Oil field water ☐ Other
<u>Top soil</u>		<u>0</u>		<u>2</u>		9. Casing: Material <u>Styrene</u> Height <u>0</u> Above or below Threaded <u>Welder</u> ☒ Surface <u>0</u> in. RMP <u>5</u> PVC <u>75</u> Weight <u>1.50</u> lbs./ft. Dia. <u>5</u> in. to <u>75</u> ft. depth Wall Thickness: inches or Dia. <u>5</u> in. to <u>75</u> ft. depth gage No. <u>200</u>
<u>fine sand.</u>		<u>2</u>		<u>9</u>		10. Screen: Manufacturer's name <u>Sunflower</u> Type <u>200</u> Dia. <u>5 1/4</u> Slot/gauze <u>1/16</u> Length <u>40 ft.</u> Set between <u>35</u> ft. and <u>75</u> ft. Gravel pack? <u>Yes</u> Size range of material <u>3/8</u>
<u>Red shale.</u>		<u>9</u>		<u>59</u>		11. Static water level: <u>35</u> ft. below land surface Date <u>5/12/78</u>
<u>Blue-Green shale.</u>		<u>59</u>		<u>64</u>		12. Pumping level below land surfaces: <u>38</u> ft. after <u>1/2</u> hrs. pumping <u>15</u> g.p.m. <u>38</u> ft. after <u>1/2</u> hrs. pumping <u>15</u> g.p.m. Estimated maximum yield <u>25-30</u> g.p.m.
<u>Red Shale</u>		<u>64</u>		<u>70</u>		13. Water sample submitted: <u>Yes</u> ☒ No ☐ Date <u>5/12/78</u>
<u>Blue-Green shale</u>		<u>70</u>		<u>73</u>		14. Well head completion: ☒ Pitless adapter <u>12</u> inches above grade
<u>Red shale.</u>		<u>73</u>		<u>80</u>		15. Well grouted? <u>Yes</u> With: <u>Neat cement</u> ☐ Bentonite ☒ Concrete ☐ Depth: From <u>3</u> ft. to <u>13</u> ft.
						16. Nearest source of possible contamination: <u>150</u> ft. Direction <u>E</u> Type <u>Septic</u> Well disinfected upon completion? ☒ Yes ☐ No
						17. Pump: Manufacturer's name <u>Valley</u> Not installed Model number <u>12501</u> HP <u>3/4</u> Vol. <u>220</u> Length of drop pipe <u>318</u> ft. capacity <u>318</u> g.p.m. Type: ☒ Submersible ☐ Turbine ☐ Jet ☐ Reciprocating ☐ Centrifugal ☐ Other
18. Elevation:		19. Remarks:		20. Water well contractor's certification:		
Topography: ☒ Hill ☐ Slope ☐ Upland ☐ Valley		<u>Customer to furnish 4'x4'x4" slab at grade around well per State Regulations</u> <u>Signel Jim Howard</u>		This well was drilled under my jurisdiction and this report is true to the best of my knowledge and belief. <u>Weninger Drilling</u> <u>318</u> Business name <u>Wichita</u> License No. <u>5/12/78</u> Address <u>Wichita</u> Signed <u>Weninger</u> Date <u>5/12/78</u> Authorized representative		

Forward the white, blue and pink copies to the Department of Health and Environment

Form WWC-5