

1 LOCATION OF WATER WELL: County: Stanford Fraction: NE 1/4 N 1/2 NE 1/4 Section Number: 27 Township Number: 27 S Range Number: 40 EW

Distance and direction from nearest town or city street address of well if located within city?


3 E - SN - 1 E - 1/2 N of Johnson

2 WATER WELL OWNER: Winger Feed yard INC.
RR#, St. Address, Box #: C/O Melvin Winger
City, State, ZIP Code: Johnson, KS. 67855

Board of Agriculture, Division of Water Resources

Application Number: 031060-00

3 LOCATE WELL'S LOCATION WITH AN "X" IN SECTION BOX:

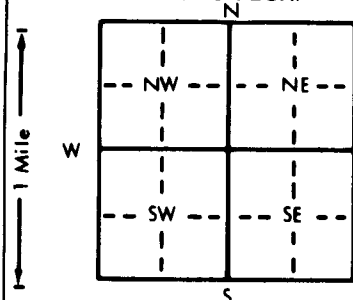

4 DEPTH OF COMPLETED WELL: 169 ft. ELEVATION: 23

Depth(s) Groundwater Encountered 1. 118 ft. 2. 108 ft. 3. 18 ft.

WELL'S STATIC WATER LEVEL 118 ft. below land surface measured on mo/day/yr 10-9-95




WELL WATER USED AS: 5 Public water supply 8 Air conditioning 11 Injection well

1 Domestic 3 Feedlot 6 Oil field water supply 9 Dewatering 12 Other (Specify below)

2 Irrigation 4 Industrial 7 Lawn and garden only 10 Monitoring well

Was a chemical/bacteriological sample submitted to Department? Yes No If yes, mo/day/yr sample was submitted

Water Well Disinfected? Yes No

5 TYPE OF BLANK CASING USED: 5 Wrought iron 8 Concrete tile CASING JOINTS: Glued Clamped

1 Steel 3 RMP (SR) 6 Asbestos-Cement 9 Other (specify below) Welded

2 PVC 4 ABS 7 Fiberglass Threaded



TYPE OF SCREEN OR PERFORATION MATERIAL: 7 PVC 10 Asbestos-cement

1 Steel 3 Stainless steel 5 Fiberglass 8 RMP (SR) 11 Other (specify)

2 Brass 4 Galvanized steel 6 Concrete tile 9 ABS 12 None used (open hole)

SCREEN OR PERFORATION OPENINGS ARE: 5 Gauzed wrapped 8 Saw cut 11 None (open hole)

1 Continuous slot 3 Mill slot 6 Wire wrapped 9 Drilled holes

2 Louvered shutter 4 Key punched 7 Torch cut 10 Other (specify)





6 GROUT MATERIAL: 1 Neat cement 2 Cement grout 3 Bentonite 4 Other


What is the nearest source of possible contamination: 10 Livestock pens 14 Abandoned water well

1 Septic tank 4 Lateral lines 7 Pit privy 11 Fuel storage 15 Oil well/Gas well

2 Sewer lines 5 Cess pool 8 Sewage lagoon 12 Fertilizer storage 16 Other (specify below)

3 Watertight sewer lines 6 Seepage pit 9 Feedyard 13 Insecticide storage

Direction from well? IN Feed lot

FROM TO LITHOLOGIC LOG FROM TO PLUGGING INTERVALS

169 118 Sand & Gravel

118 108 Bentonite

108 18 Sand & Gravel

18 8 Bentonite

7 CONTRACTOR'S OR LANDOWNER'S CERTIFICATION: This water well was (1) constructed, (2) reconstructed, or (3) plugged under my jurisdiction and was completed on (mo/day/year) 10-9-95 and this record is true to the best of my knowledge and belief. Kansas Water Well Contractor's License No. 10-12-95 This Water Well Record was completed on (mo/day/yr) 10-12-95 under the business name of Webber Supply Co. INC. by (signature) Ken Martin

INSTRUCTIONS: Use typewriter or ball point pen. PLEASE PRESS FIRMLY and PRINT clearly. Please fill in blanks, underline or circle the correct answers. Send top three copies to Kansas Department of Health and Environment, Bureau of Water, Topeka, Kansas 66620-7320. Telephone: 913-296-5545. Send one to WATER WELL OWNER and retain one for your records.