


## WATER WELL RECORD Form WWC-5 KSA 82a-1212

1 LOCATION OF WATER WELL: COUNTY: 094 STANTON	Fraction <b>SW</b> 1/4 NW 1/4 NE 1/4	Section Number 27	Township Number T 27 S	Range Number R 40 W
--	---	----------------------	---------------------------	------------------------

Distance and direction from nearest town or city street address of well if located within city?  
FROM JOHNSON; APPX 6 3/4 MILES NORTH & 3 MILES EAST

2 WATER WELL OWNER: WINGER FEED YARD, INC.  
RR#, St. Address, Box #: PO BOX 685  
City, State, ZIP code: JOHNSON, KS 67855-0685  
Board of Agriculture, Division of Water Resources  
Application Number: 8704

3 LOCATE WELL'S LOCATION WITH  
AN "X" IN SECTION BOX:

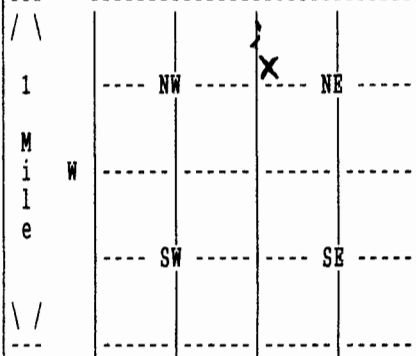

4 DEPTH OF COMPLETED WELL 637 ELEVATION: 0  
Depth(s) Groundwater Encountered 1. 0 ft. 2. 0 ft. 3. 0 ft.

WELL'S STATIC WATER LEVEL 122 ft. below land surface measured on mo/day/yr 03/19/05  
Pump test data: Well water was 55 ft. after 4 hours pumping 840 gpm

Estimated Yield 0 gpm: Well water was 0 ft. after 0 hours pumping 0 gpm

Bore Hole Diameter 24 in. to 637 ft., and in. to 0 ft.

WELL WATER TO BE USED AS: 02 IRRIGATION

Was a chemical/bacteriological sample submitted to department? No;  
If yes, mo/day/yr sample was submitted Water well disinfected? Yes

5 TYPE OF BLANK CASING USED: 01 STEEL CASING JOINTS: WELDED  
Blank casing diameter 16 in. to 637 ft., Dia in. to 0 ft., Dia in. to 0 ft.  
Casing height above land surface 12 in., weight 42 lbs/ft. Wall thickness or gauge No. .250  
TYPE OF SCREEN OR PERFORATION MATERIAL: 01 STEEL  
SCREEN OR PERFORATION OPENINGS ARE: 01 CONT. SLOT

SCREEN PERFORATED INTERVALS:	From 132 ft. to 292 ft.,	From 0 ft. to 0 ft.
	From 292 ft. to 632 ft.,	From 0 ft. to 0 ft.
GRAVEL PACK INTERVALS:	From 20 ft. to 637 ft.,	From 0 ft. to 0 ft.
	From 0 ft. to 0 ft.,	From 0 ft. to 0 ft.

6 GROUT MATERIAL 03 BENTONITE  
Grout Intervals: From 0 ft. to 20 ft., From 0 ft. to 0 ft., From 0 ft. to 0 ft.  
What is the nearest source of possible contamination: NONE OBSERVED  
Direction from well? How many feet? 0

FROM	TO	LITHOLOGIC LOG	FROM	TO	PLUGGING INTERVALS
0	2	02 SILT			
2	10	04 SANDY CLAY 31 CALICHE			
10	14	05 SAND			
14	35	05 SAND 11 GRAVEL			
35	43	01 CLAY			
43	53	07 FINE SAND			
53	58	01 CLAY			
58	80	07 FINE SAND 01 CLAY			
80	120	05 SAND			
120	140	05 SAND			

7 CONTRACTOR'S OR LANDOWNER'S CERTIFICATION: This water well was Constructed under my jurisdiction and was completed on (mo/day/year) 03/17/05 and this record is true to the best of my knowledge and belief. Kansas Water Well Contractor's License No. 145 This Water Well Record was completed on (mo/day/yr) 06/16/05 under the business name of HENKLE DRILLING & SUPPLY by (signature)

(Continued)

WATER WELL RECORD Form WWC-5 KSA 82a-1212

1 LOCATION OF WATER WELL:	Fraction	Section Number	Township Number	Range Number
COUNTY: 094 STANTON	SE 1/4 NW 1/4 NE 1/4	27	T 27 S	R 40 W

2 WATER WELL OWNER: WINGER FEED YARD, INC.

RR#, St. Address, Box # : PO BOX 685

City, State, ZIP code : JOHNSON, KS 67855-0685

Board of Agriculture, Division of Water Resources

Application Number: 8704

FROM	TO	LITHOLOGIC LOG
140	195	07 FINE SAND 08 MEDIUM SAND 01 CLAY
195	204	01 CLAY 05 SAND
204	213	07 FINE SAND 08 MEDIUM SAND
213	225	01 CLAY 20 LIMESTONE
225	241	07 FINE SAND 01 CLAY
241	251	05 SAND
251	263	01 CLAY
263	273	01 CLAY 05 SAND
273	280	01 CLAY
280	301	07 FINE SAND 08 MEDIUM SAND
301	306	01 CLAY
306	320	23 SANDSTONE 31 CALICHE
320	324	31 CALICHE 20 LIMESTONE
320	632	31 CALICHE 20 LIMESTONE 23 SANDSTONE
330	344	31 CALICHE 23 SANDSTONE
344	368	31 CALICHE 23 SANDSTONE
368	424	19 SHALE 20 LIMESTONE
424	440	19 SHALE 20 LIMESTONE 23 SANDSTONE
440	462	19 SHALE 23 SANDSTONE
462	481	19 SHALE 31 CALICHE 23 SANDSTONE
481	518	23 SANDSTONE 31 CALICHE
518	519	20 LIMESTONE
519	540	23 SANDSTONE 31 CALICHE
540	560	23 SANDSTONE 31 CALICHE
560	602	31 CALICHE 23 SANDSTONE 20 LIMESTONE
602	620	31 CALICHE 23 SANDSTONE 20 LIMESTONE
632	642	31 CALICHE
642	660	19 SHALE

7 CONTRACTOR'S OR LANDOWNER'S CERTIFICATION: This water well was Constructed under my jurisdiction and was completed on (mo/day/year) 03/17/05 and this record is true to the best of my knowledge and belief. Kansas Water Well Contractor's License No. 145 This Water Well Record was completed on (mo/day/yr) 06/16/05 under the business name of HENKLE DRILLING & SUPPLY by (signature) *Bump Reichman*