

County:     Cheyenne     Fraction:     NW SE NW     Sec.     27     T.     3     S R.     40     W

**CORRECTION(S) to WATER WELL COMPLETION RECORD Form WWC-5 (to rectify lacking or incorrect information)**


Owner: <u>    El Paso Remediation Co.    </u>	MW <u>    17    </u>
If location corrected, was listed as: Section-Township-Range: _____ Fraction (1/4 calls): _____	Location changed to: _____ _____
Other changes: Initial statements: <u>    Well Static Water Level 3329.68    </u>	
Changed to: <u>    Well Static Water Level changed to 44.49    </u>	
Comments: _____	
Verification method: <u>    Verified with Southwest Environmental Engineering    </u>	
	Initials: <u>    SH    </u> Date: <u>    08/12/2022    </u>
Submitted by: <input checked="" type="checkbox"/> Kansas Geological Survey, Data Resources Library, 1930 Constant Ave., Lawrence, KS 66047-3724 <input type="checkbox"/> Kansas Dept. of Health & Environment, Bureau of Water, 1000 SW Jackson, Suite 420, Topeka, KS 66612-1367	

**WATER WELL PLUGGING RECORD Form WWC-5P KSA 82a-1212 ID NO. MW 17**

<b>1 LOCATION OF WATER WELL:</b> County: <u>Cheyenne</u>	Fraction <u>¼ nw ¼ se ¼ nw ¼</u>	Section Number <u>27</u>	Township Number <u>T 3 S</u>	Range Number <u>40</u> <input type="checkbox"/> E <input checked="" type="checkbox"/> W
---	-------------------------------------	-----------------------------	---------------------------------	--

Street/Rural Address of Well Location; if unknown, distance & direction from nearest town or intersection: If at owner's address, check here <input type="checkbox"/> Highway 36 & Denison St St Francis, KS	<b>Global Positioning Systems (GPS) information:</b> Latitude: <u>39.76698</u> (in decimal degrees) Longitude: <u>-101.79902</u> (in decimal degrees) Elevation: <u>3382.5</u> Horizontal Datum: <input checked="" type="checkbox"/> WGS84, <input type="checkbox"/> NAD83, <input type="checkbox"/> NAD27 Collection Method:
--	--

<b>2 WATER WELL OWNER:</b> El Paso Remediation Co. RR#, St. Address, Box #: <u>1001 Louisiana St, Room 757C</u> City, State ZIP Code: <u>Houston, TX 77002</u>	<input type="checkbox"/> GPS unit (Make/Model): <input checked="" type="checkbox"/> Digital Map/Photo, <input type="checkbox"/> Topographic Map, <input type="checkbox"/> Land Survey Est. Accuracy: <input type="checkbox"/> < 3 m, <input checked="" type="checkbox"/> 3-5 m, <input type="checkbox"/> 5-15 m, <input type="checkbox"/> > 15 m
--	--

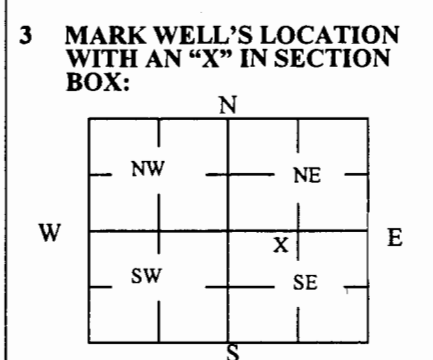

**4 DEPTH OF WELL** 49.90 ft.  
**WELL'S STATIC WATER LEVEL** 3329.68 ft.  
**WELL WAS USED AS:**

<input type="checkbox"/> Domestic	<input type="checkbox"/> Public Water Supply	<input type="checkbox"/> Dewatering
<input type="checkbox"/> Irrigation	<input type="checkbox"/> Oil Field Water Supply	<input checked="" type="checkbox"/> Monitoring
<input type="checkbox"/> Feedlot	<input type="checkbox"/> Domestic (Lawn & Garden)	<input type="checkbox"/> Injection Well
<input type="checkbox"/> Industrial	<input type="checkbox"/> Air Conditioning	<input type="checkbox"/> Other <u>MW-17</u>

Was a chemical/bacteriological sample submitted to Department? Yes  No

**5 TYPE OF BLANK CASING USED:**

<input checked="" type="checkbox"/> Steel	<input type="checkbox"/> RMP (SR)	<input type="checkbox"/> Wrought	<input type="checkbox"/> Fiberglass	<input type="checkbox"/> Other (Specify below)
<input checked="" type="checkbox"/> PVC	<input type="checkbox"/> ABS	<input type="checkbox"/> Asbestos-Cement	<input type="checkbox"/> Concrete Tile	

Blank casing diameter 2 in. Was casing pulled? Yes  No  If yes, how much \_\_\_\_\_  
 Casing height above or below land surface -36 in.

**6 GROUT PLUG MATERIAL:**  Neat cement  Cement grout  Bentonite  Other \_\_\_\_\_

Grout Plug Intervals: From 0.5 ft. to 49.90 ft., From \_\_\_\_\_ ft. to \_\_\_\_\_ ft., From \_\_\_\_\_ ft. to \_\_\_\_\_ ft.

What is the nearest source of possible contamination:

<input type="checkbox"/> Septic tank	<input type="checkbox"/> Seepage pit	<input type="checkbox"/> Fuel storage	<input checked="" type="checkbox"/> Other (specify below)
<input type="checkbox"/> Sewer lines	<input type="checkbox"/> Pit privy	<input type="checkbox"/> Fertilizer storage	<u>Fuel pump station</u>
<input type="checkbox"/> Watertight sewer lines	<input type="checkbox"/> Sewage lagoon	<input type="checkbox"/> Insecticide storage	
<input type="checkbox"/> Lateral lines	<input type="checkbox"/> Feedyard	<input type="checkbox"/> Abandoned water well	Direction from well? <u>210 feet</u>
<input type="checkbox"/> Cess pool	<input type="checkbox"/> Livestock pens	<input type="checkbox"/> Oil well/Gas well	How many feet? <u>northwest</u>

FROM	TO	PLUGGING MATERIALS	FROM	TO	PLUGGING MATERIALS
0	1.5	Native Soil			
1.5	49.90	Hi-solids/bentonite chips			

**7 CONTRACTOR'S OR LANDOWNER'S CERTIFICATION:** This water well was plugged under my jurisdiction and was completed on (mo/day/year) 04/18/2022 and this record is true to the best of my knowledge and belief. Kansas Water Well Contractor's License No. 929. This Water Well Record was completed on (mo/day/year) 05/13/2022 under the business name of Southwest Environmental Engineering LLC by (signature) *Josephine B. Richer*