USE TYPEWRITER OR BALL POINT PEN-PRESS FIRMLY, PRINT CLEARLY.

WATER WELL RECORD
KSA 82a-1201-1215

Kansas Department of Health and Environment-Division of Environment
(Water well Contractors)
Topeka, Kansas 66620

1. Location of well:	County	Fraction	Section number	Township number	Range number
	Stanton	SE 1/4 NW 1/4 NE 1/4	5	T 27 S	R 40 E/W

2. Distance and direction from nearest town or city: 10N-2½E
Street address of well location if in city: ¾N-Johnson Ks

3. Owner of well: Jim Dimmitt
R.R. or street:
City, state, zip code: Johnson, Ks 67855

4. Locate with "X" in section below:

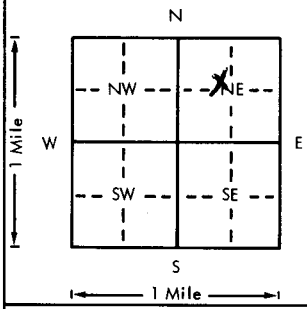

Sketch map:

5. Type and color of material	From	To
CLAY	0	30'
Sand	30	125
Shale	125	170
Shale & Sandstone 30%	170	250

(Use a second sheet if needed)

6. Bore hole dia. 9 in. Completion date 5/79
Well depth 250' ft.

7. __ Cable tool ✓ Rotary __ Driven __ Dug
__ Hollow rod __ Jetted __ Bored __ Reverse rotary

8. Use: __ Domestic __ Public supply __ Industry
__ Irrigation __ Air conditioning ✓ Stock
__ Lawn __ Oil field water __ Other

9. Casing: Material ____ Height: Above or below
Threaded ____ Welded ____ Surface 18" in.
RMP ____ PVC 200 Weight ____ lbs./ft.
Dia. 5" in. to 10 ft. depth Wall Thickness: inches or
Dia. ____ in. to ____ ft. depth gage No. 1261

10. Screen: Manufacturer's name Jet Stream
Type PVC. Dia. 5"
Slot/gauze Slot Length 30'
Set between 300' ft. and 330' ft.
____ ft. and ____ ft.
Gravel pack? ✓ Size range of material #1

11. Static water level: mo./day/yr.
80' ft. below land surface Date 5/79

12. Pumping level below land surfaces:
____ ft. after ____ hrs. pumping ____ g.p.m.
____ ft. after ____ hrs. pumping ____ g.p.m.
Estimated maximum yield Unknown g.p.m.

13. Water sample submitted: mo./day/yr.
__ Yes ✓ No Date

14. Well head completion:
__ Pitless adapter 18" Inches above grade

15. Well grouted? ✓
With: __ Neat cement __ Bentonite ✓ Concrete
Depth: From 0 ft. to 20 ft.

16. Nearest source of possible contamination:
ft. ____ Direction ____ Type ____
Well disinfected upon completion? ✓ Yes __ No

17. Pump: __ Not installed
Manufacturer's name Aermotor.
Model number 9' HP ____ Volts ____
Length of drop pipe 100' ft. capacity 6 g.p.m.
Type:
__ Submersible __ Turbine
__ Jet __ Reciprocating
__ Centrifugal windmill ✓ Other

18. Elevation:

Topography:
__ Hill
__ Slope
__ Upland
__ Valley

19. Remarks:

20. Water well contractor's certification:
This well was drilled under my jurisdiction and this report is true to the best of my knowledge and belief.
Jim Smith Pump Service 160
Business name License No.
Address Johnson, Ks 67855
Signed James Ray Smith Date 10/79
Authorized representative

T 27 R 40 E/W Sec 5 1/4 SE 1/4 NW 1/4 NE

Forward the white, blue and pink copies to the Department of Health and Environment

Form WWC-5