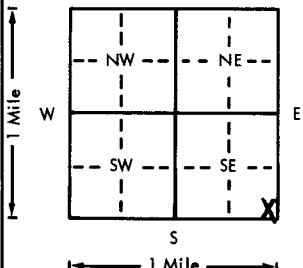


USE TYPEWRITER OR BALL  
POINT PEN-PRESS FIRMLY,  
PRINT CLEARLY.

WATER WELL RECORD  
KSA 82a-1201-1215

Kansas Department of Health and  
Environment-Division of Environment  
(Water well Contractors)  
Topeka, Kansas 66620

1. Location of well:		County <b>Stanton</b> <b>Frank</b>	Fraction <b>SE 1/4 SE 1/4 SE 1/4</b>	Section number <b>26</b>	Township number <b>T 27 S</b>	Range number <b>R 40 E</b>
2. Distance and direction from nearest town or city: <b>15 miles west, 6 north, 1 west of Ulysses, Ks.</b>			3. Owner of well: <b>Winger Cattle Co.</b> R.R. or street: <b>Johnson, Ks. 67855</b> City, state, zip code:			
4. Locate with "X" in section below:		Sketch map:		6. Bore hole dia. <u>9 1/4</u> in. Completion date <u>12/21/77</u> Well depth <u>270</u> ft.		
				7. <input checked="" type="checkbox"/> Cable tool <input checked="" type="checkbox"/> Rotary <input type="checkbox"/> Driven <input type="checkbox"/> Dug <input type="checkbox"/> Hollow rod <input type="checkbox"/> Jetted <input type="checkbox"/> Bored <input type="checkbox"/> Reverse rotary		
5. Type and color of material		From	To	8. Use: <input checked="" type="checkbox"/> Domestic <input type="checkbox"/> Public supply <input type="checkbox"/> Industry <input type="checkbox"/> Irrigation <input type="checkbox"/> Air conditioning <input type="checkbox"/> Stock <input type="checkbox"/> Lawn <input type="checkbox"/> Oil field water <input type="checkbox"/> Other		
Surface		0	2	9. Casing: Material <u>styrene</u> Height: Above or below Threaded <u>glued</u> Welded <input type="checkbox"/> Surface <input type="checkbox"/> in. RMP <input type="checkbox"/> PVC <input type="checkbox"/> Weight <input type="checkbox"/> lbs./ft. Dia. <u>5</u> in. to <u>230</u> ft. depth Wall Thickness: inches or Dia. <input type="checkbox"/> in. to <input type="checkbox"/> ft. depth Gauge No. <u>.320</u>		
Brown sandy clay		2	34	10. Screen: Manufacturer's name <u>Sunflower</u> Type <u>styrene</u> Dia. <u>5"</u> Slot/gauze <u>1/16"</u> Length <u>40'</u> Set between <u>230</u> ft. and <u>270</u> ft. <input checked="" type="checkbox"/> ft. and <input type="checkbox"/> ft. Gravel pack? <input type="checkbox"/> Size range of material <input type="checkbox"/>		
Brown & gray clay w/fine sand strips		34	46	11. Static water level: <u>11 1/2</u> ft. below land surface Date <u>11/22/77</u> mo./day/yr.		
Brown sandy clay		46	68	12. Pumping level below land surfaces: <u>130</u> ft. after <u>12</u> hrs. pumping <u>12</u> g.p.m. <input type="checkbox"/> ft. after <input type="checkbox"/> hrs. pumping <input type="checkbox"/> g.p.m. Estimated maximum yield <u>40</u> g.p.m.		
Fine to medium sand w/clay breakers		68	94	13. Water sample submitted: <input type="checkbox"/> Yes <input checked="" type="checkbox"/> No Date <input type="checkbox"/>		
Medium to coarse sand w/cly breakers & rock strips		94	110	14. Well head completion: <input checked="" type="checkbox"/> Pitless adapter <u>24</u> inches above grade		
Brown clay w/clay strips & some very fine sand strips		110	151	15. Well grouted? <input checked="" type="checkbox"/> With: <input checked="" type="checkbox"/> Neat cement <input type="checkbox"/> Bentonite <input type="checkbox"/> Concrete Depth: From <u>0</u> ft. to <u>10</u> ft.		
Brown clay w/fine to coarse sand strips		151	170	16. Nearest source of possible contamination: ft. <u>180</u> Direction <u>north</u> Type <u>sewer line</u> Well disinfected upon completion? <input checked="" type="checkbox"/> Yes <input type="checkbox"/> No		
Brown sandy clay w/very fine to fine sand strips		170	210	17. Pump: <input checked="" type="checkbox"/> Not installed Manufacturer's name <input type="checkbox"/> Model number <input type="checkbox"/> HP <input type="checkbox"/> Volts <input type="checkbox"/> Length of drop pipe <input type="checkbox"/> ft. capacity <input type="checkbox"/> g.p.m. Type: <input type="checkbox"/> Submersible <input type="checkbox"/> Turbine <input type="checkbox"/> Jet <input type="checkbox"/> Reciprocating <input type="checkbox"/> Centrifugal <input type="checkbox"/> Other		
Brown sandy clay, w/very fine sand strips		210	230	18. Elevation:		
Fine to medium sand		230	236	19. Remarks:		
Brown sandy clay w/fine to medium sand strips		236	270			
(Use a second sheet if needed)						
20. Water well contractor's certification: This well was drilled under my jurisdiction and this report is true to the best of my knowledge and belief. <b>Houck Bros. Drlg. Co.</b> License No. <u>164</u> Business name <u>Box 487, Ulysses, Ks. 67855</u> Address <u>M. Beard</u> Date <u>Dec 27-77</u> Signed <u>M. Beard</u> Authorized representative						