


USE TYPEWRITER OR BALL POINT PEN-PRESS FIRMLY, PRINT CLEARLY.

WATER WELL RECORD
KSA 82a-1201-1215

Kansas Department of Health and Environment-Division of Environment (Water well Contractors) Topeka, Kansas 66620

| | | | | | |
|----------------------|--------------------------|---|-----------------------------|---|---------------------------|
| 1. Location of well: | County Stanton | Fraction SE 1/4 SE 1/4 NW 1/4 | Section number 34 | Township number T 27 S R 40 E/W | Range number 40 |
|----------------------|--------------------------|---|-----------------------------|---|---------------------------|

2. Distance and direction from nearest town or city: **Hwy jct. at Johnson** Owner of well: **Winger Cattle Co.**
 Ks. **4 miles east-5 1/2 miles north** R.R. or street: **1/2 Melvin Winger**
 Street address of well location if in city: City, state, zip code: **Johnson, Ks. 67855**

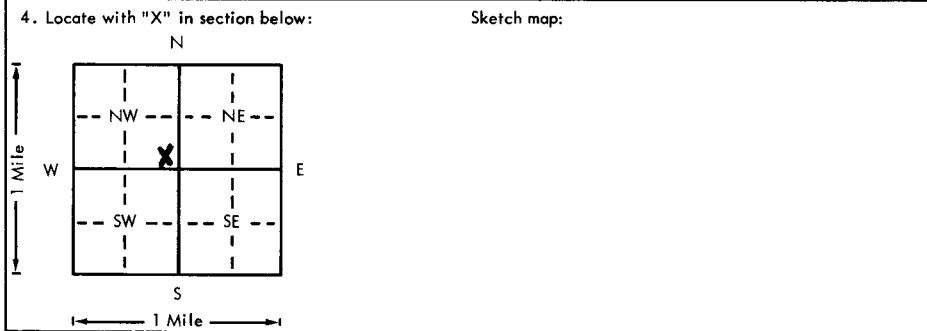

6. Bore hole dia. 26 in. Completion date _____
 Well depth 584 ft. 9-13-79

7. Cable tool Rotary Driven Dug
 Hollow rod Jetted Bored Reverse rotary

8. Use: Domestic Public supply Industry
 Irrigation Air conditioning Stock
 Lawn Oil field water Other

9. Casing: Material Steel Height: Above or below
 Threaded _____ Welded Surface 18 in.
 RMP _____ PVC _____ Weight 36.8 lbs./ft.
 Dia. 16 in. to 233.4 depth, Wall Thickness: inches or
 Dia. _____ in. to _____ ft. depth, gage No. .219

| 5. Type and color of material | From | To |
|---|------------|------------|
| Surface | 0 | 2 |
| Sandy clay w/fine sand | 2 | 105 |
| Medium to coarse sand w/clay breakers | 105 | 125 |
| Brown sandy clay w/fine sand strips | 125 | 180 |
| Fine to coarse sand w/embedded sand 10 ft. | 180 | 202 |
| Sandy clay | 202 | 219 |
| Fine to medium sand w/clay breakers 31 ft. | 219 | 257 |
| Sandy clay w/lime shells & fine sand strips | 257 | 337 |
| Sandy clay, yellow chlak, sandrock & Dakota 10ft | 337 | 358 |
| YELLOW chalk, brown shale, sandrock & Dakota | 358 | 378 |
| Blue shale & Dakota hard | 378 | 415 |
| Blue shale & Dakota 12 ft | 415 | 494 |
| Dakota & Cheyenne 27 ft. | 494 | 524 |
| Blue shale, Cheyenne & Dakota 4 ft. | 524 | 548 |
| Blue hsale, Cheyenne & Dakota 9 ft. | 548 | 584 |
| (Use a second sheet if needed) | | |

10. Screen: Manufacturer's name Lakewood Pipe
 Type steel Dia. 16"
 Slot/gauze 3/16" Length 320.8'
 Set between 263.4 ft. and 584 ft.
 _____ ft. and _____ ft.
 Gravel pack? Size range of material 1/4 x 5/8"

11. Static water level: _____ mo./day/yr.
135 ft. below land surface Date 8-21-79

12. Pumping level below land surfaces:
325 ft. after 14 hrs. pumping 1220 g.p.m.
 _____ ft. after _____ hrs. pumping _____ g.p.m.
 Estimated maximum yield 1500 g.p.m.

13. Water sample submitted: _____ mo./day/yr.
 Yes No Date _____

14. Well head completion:
 Pitless adapter 18 Inches above grade

15. Well grouted?
 With: Neat cement Bentonite Concrete
 Depth: From 0 ft. to 10 ft.

16. Nearest source of possible contamination:
 ft. _____ Direction _____ Type field
 Well disinfected upon completion? Yes No

17. Pump: Not installed
 Manufacturer's name _____
 Model number _____ HP _____ Volts _____
 Length of drop pipe _____ ft. capacity _____ g.p.m.
 Type:
 Submersible Turbine
 Jet Reciprocating
 Centrifugal Other

18. Elevation: _____
 Topography: _____ Hill
 Slope
 _____ Upland
 _____ Valley

19. Remarks:
30 feet of Johnson Screen set between 233.4 feet & 263.4 feet

20. Water well contractor's certification:
 This well was drilled under my jurisdiction and this report is true to the best of my knowledge and belief.

Houck Bros. Drlg. Co. 164
 Business name _____ License No. _____
 Address **Box 487, Ulysses, Ks.**
 Signed M. Beard Date 12-4-79
 Authorized representative

27
 400
 37
 SE
 SE
 SE
 1/4
 1/4
 1/4