


1 LOCATION OF WATER WELL: : Fraction : Section Number : Township Number : Range Number
 COUNTY: 094 STANTON : NW 1/4 NW 1/4 NE 1/4 : 34 : T 27 S : R 40 W

Distance and direction from nearest town or city street address of well if located within city?
 APPROX. 6 MILES NORTH AND 3 1/2 MILES EAST OF JOHNSON

2 WATER WELL OWNER: MELVIN WINGER
 RR#, St. Address, Box #: RT. 1 Board of Agriculture, Division of Water Resources
 City, State, ZIP code : JOHNSON, KS 67855- Application Number: 31,059

3 LOCATE WELL'S LOCATION WITH AN "X" IN SECTION BOX: 4 DEPTH OF COMPLETED WELL 633 ELEVATION: 0
 Depth(s) Groundwater Encountered 1. 0 ft. 2. 0 ft. 3. 0 ft.

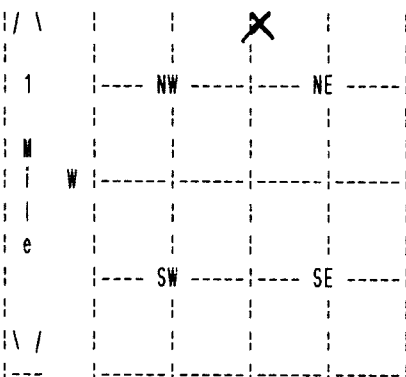

WELL'S STATIC WATER LEVEL 197 ft. below land surface measured on mo/day/yr 03/19/93
 Pump test data: Well water was 409 ft. after 12 hours pumping 775 gpm
 Estimated Yield 775 gpm: Well water was 0 ft. after 0 hours pumping 0 gpm
 Bore Hole Diameter 24 in. to 633 ft., and in. to 0 ft.
 WELL WATER TO BE USED AS: 02 IRRIGATION
 Was a chemical/bacteriological sample submitted to department? No ;
 If yes, mo/day/yr sample was submitted Water well disinfected? No

5 TYPE OF BLANK CASING USED: 01 STEEL CASING JOINTS: WELDED
 Blank casing diameter 16 in. to 633 ft., Dia in. to 0 ft., Dia in. to 0 ft.
 Casing height above land surface 12 in., weight 42 lbs/ft. Wall thickness or gauge No. .250
 TYPE OF SCREEN OR PERFORATION MATERIAL: 01 STEEL
 SCREEN OR PERFORATION OPENINGS ARE: 01 CONT. SLOT

SCREEN PERFORATED INTERVALS: From 248 ft. to 278 ft., From 503 ft. to 633 ft.
 From 360 ft. to 390 ft., From 278 ft. to 360 ft.
 GRAVEL PACK INTERVALS: From 20 ft. to 633 ft., From 0 ft. to 0 ft.
 From 0 ft. to 0 ft., From 0 ft. to 0 ft.

6 GROUT MATERIAL 03 BENTONITE
 Grout Intervals: From 0 ft. to 20 ft., From 0 ft. to 0 ft., From 0 ft. to 0 ft.
 What is the nearest source of possible contamination: 14 ABAND. WELL
 Direction from well? SOUTH How many feet? 240

FROM	TO	LITHOLOGIC LOG	FROM	TO	PLUGGING INTERVALS
0	2	01 CLAY			
2	56	04 SANDY CLAY 31 CALICHE			
56	60	07 FINE SAND 08 MEDIUM SAND			
60	100	01 CLAY 07 FINE SAND			
100	110	07 FINE SAND 08 MEDIUM SAND			
110	124	04 SANDY CLAY 20 LIMESTONE			
124	146	07 FINE SAND 08 MEDIUM SAND 04 SANDY CLAY			
146	218	01 CLAY 04 SANDY CLAY			
218	224	07 FINE SAND 08 MEDIUM SAND			
224	240	01 CLAY 04 SANDY CLAY			

7 CONTRACTOR'S OR LANDOWNER'S CERTIFICATION: This water well was constructed under my jurisdiction and was completed on (mo/day/year) 03/19/93 and this record is true to the best of my knowledge and belief. Kansas Water Well Contractor's License No. 145 This Water Well Record was completed on (mo/day/yr) 03/24/93 under the business name of HENKLE DRILLING & SUPPLY by (signature)

1 LOCATION OF WATER WELL: : Fraction : Section Number : Township Number : Range Number
 COUNTY: 094 STANTON : NW 1/4 NW 1/4 NE 1/4 : 34 : T 27 S : R 40 W

2 WATER WELL OWNER: MELVIN WINGER
 RR#, St. Address, Box #: RT. 1 Board of Agriculture, Division of Water Resources
 City, State, ZIP code : JOHNSON, KS 67055- Application Number: 31,059

SCREEN PERFORATED INTERVALS: From 390 ft. to 503 ft., From 0 ft. to 0 ft.
 From 0 ft. to 0 ft., From 0 ft. to 0 ft.

FROM	TO	LITHOLOGIC LOG
240	252	07 FINE SAND 08 MEDIUM SAND
252	263	04 SANDY CLAY 20 LIMESTONE
263	273	07 FINE SAND 08 MEDIUM SAND 09 COARSE SAND
273	278	07 FINE SAND 08 MEDIUM SAND
278	340	04 SANDY CLAY 20 LIMESTONE 07 FINE SAND
340	352	07 FINE SAND 08 MEDIUM SAND 04 SANDY CLAY
352	360	04 SANDY CLAY 28 ROCK
360	366	28 ROCK 07 FINE SAND 08 MEDIUM SAND
366	390	23 SANDSTONE
390	482	21 SHALE & LNST
482	489	23 SANDSTONE 19 SHALE
489	503	21 SHALE & LNST 23 SANDSTONE
503	604	23 SANDSTONE
604	612	20 LIMESTONE
612	630	23 SANDSTONE
630	642	20 LIMESTONE

7 CONTRACTOR'S OR LANDOWNER'S CERTIFICATION: This water well was Constructed under my jurisdiction and was completed on (mo/day/year) 03/19/93 and this record is true to the best of my knowledge and belief. Kansas Water Well Contractor's License No. 145 This Water Well Record was completed on (mo/day/yr) 03/24/93 under the business name of HENKLE DRILLING & SUPPLY by (signature) *Bruce Reichmuth*