


1 LOCATION OF WATER WELL: Fraction SW 1/4 NW 1/4 SE 1/4 Section Number 1 Township Number T 27 S Range Number R 41 E/W  
 County: Stanton

Distance and direction from nearest town or city street address of well if located within city?  
17 south, 1/2 east 1/4 north of Syracuse, KS

2 WATER WELL OWNER: Bar Frying Pan Ranches, Inc.  
 RR#, St. Address, Box # : 1720 Little Kitten Ave Board of Agriculture, Division of Water Resources  
 City, State, ZIP Code : Manhattan, KS 66502 Application Number: 15595

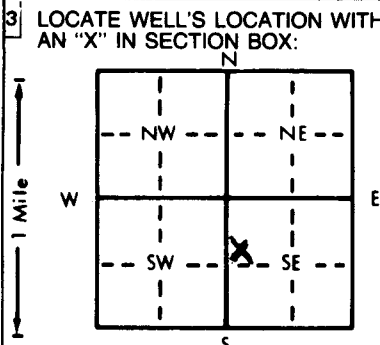

4 DEPTH OF COMPLETED WELL... 613 ft. ELEVATION: .....

Depth(s) Groundwater Encountered 1. 220 ft. 2. .... ft. 3. .... ft.

WELL'S STATIC WATER LEVEL... 220 ft. below land surface measured on mo/day/yr .....

Pump test data: Well water was 300 ft. after 1 hours pumping 650 gpm

Est. Yield 1,000 gpm: Well water was 340 ft. after 1 hours pumping 750 gpm

Bore Hole Diameter... 26 in. to ..... ft., and ..... in. to ..... ft.

WELL WATER TO BE USED AS: 5 Public water supply 8 Air conditioning 11 Injection well  
 1 Domestic 3 Feedlot 6 Oil field water supply 9 Dewatering 12 Other (Specify below)  
2 Irrigation 4 Industrial 7 Lawn and garden only 10 Monitoring well .....

Was a chemical/bacteriological sample submitted to Department? Yes.....No...X.....; If yes, mo/day/yr sample was submitted

Water Well Disinfected? Yes X No

5 TYPE OF BLANK CASING USED:

1 Steel 3 RMP (SR) 5 Wrought iron 8 Concrete tile CASING JOINTS: Glued X Clamped .....

2 PVC 4 ABS 6 Asbestos-Cement 9 Other (specify below) Welded .....

7 Fiberglass Threaded .....

Blank casing diameter ..... 16 in. to 250 ft., Dia ..... 16 in. to 290-410 ft., Dia 16 in. to 430-550 ft.

Casing height above land surface ..... 12 in., weight ..... 26 lbs./ft. Wall thickness or gauge No. SCH 80

TYPE OF SCREEN OR PERFORATION MATERIAL:

1 Steel 3 Stainless steel 5 Fiberglass 7 PVC 10 Asbestos-cement  
 2 Brass 4 Galvanized steel 6 Concrete tile 8 RMP (SR) 11 Other (specify) .....

12 None used (open hole)

SCREEN OR PERFORATION OPENINGS ARE:

1 Continuous slot 3 Mill slot 5 Gauzed wrapped 8 Saw cut 11 None (open hole)  
 2 Louvered shutter 4 Key punched 6 Wire wrapped 9 Drilled holes  
 7 Torch cut 10 Other (specify) .....

SCREEN-PERFORATED INTERVALS: From ..... 250 ft. to ..... 290 ft., From ..... 410 ft. to ..... 430 ft.  
 From ..... 550 ft. to ..... 610 ft., From ..... ft. to ..... ft.

GRAVEL PACK INTERVALS: From ..... 20 ft. to ..... 610 ft., From ..... ft. to ..... ft.  
 From ..... ft. to ..... ft., From ..... ft. to ..... ft.

6 GROUT MATERIAL: 1 Neat cement 2 Cement grout 3 Bentonite 4 Other .....

Grout Intervals: From ..... 0 ft. to ..... 20 ft., From ..... ft. to ..... ft., From ..... ft. to ..... ft.

What is the nearest source of possible contamination:

1 Septic tank 4 Lateral lines 7 Pit privy 10 Livestock pens 14 Abandoned water well  
 2 Sewer lines 5 Cess pool 8 Sewage lagoon 11 Fuel storage 15 Oil well/Gas well  
 3 Watertight sewer lines 6 Seepage pit 9 Feedyard 12 Fertilizer storage 16 Other (specify below)  
 13 Insecticide storage

Direction from well? south How many feet? 275

FROM	TO	LITHOLOGIC LOG	FROM	TO	PLUGGING INTERVALS
0	16	top soil & red clay	295	361	blue clay
16	32	light brown clay	361	368	blue clay & cemented sand
32	49	sand & little clay	368	377	blue shale (very very hard)
49	72	sand	377	387	blue shale
72	86	clay (brown)	387	393	sandstone (soft)
86	114	sand (fine) & little clay	393	405	gray clay & little sandstone
114	132	clay (brown) & little sand	405	410	rock (very very very hard)
132	147	sand (fine) & little clay	410	426	red & white clay & sandstone (hard)
147	164	clay & little sand	426	443	red clay & sandstone
164	196	clay (brown) & little sand	443	475	red & white clay & little sandstone
196	213	clay (brown) & cemented sand (firm)	475	505	sandstone & little clay
213	229	sandstone & little clay (hard)	505	613	sandstone & little white clay
229	246	sandstone (fine) & little clay (hard)			
246	262	sandstone (fine)			
278	295	sandstone (fine) & little clay			

7 CONTRACTOR'S OR LANDOWNER'S CERTIFICATION: This water well was (1) constructed, (2) reconstructed, or (3) plugged under my jurisdiction and was completed on (mo/day/year) ..... May 24, 1994 ..... and this record is true to the best of my knowledge and belief. Kansas Water Well Contractor's License No. 473 This Water Well Record was completed on (mo/day/yr) ..... May 24, 1994 ..... under the business name of Tyler Water Well Service by (signature) [Signature]

INSTRUCTIONS: Use typewriter or ball point pen. PLEASE PRESS FIRMLY and PRINT clearly. Please fill in blanks, underline or circle the correct answers. Send top three copies to Kansas Department of Health and Environment, Bureau of Water, Topeka, Kansas 66620-0001. Telephone: 913-296-5545. Send one to WATER WELL OWNER and retain one for your records.