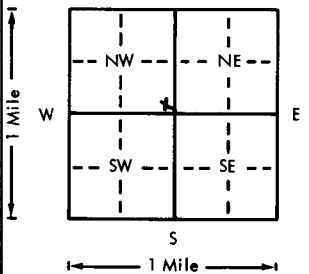


USE TYPEWRITER OR BALL POINT PEN-PRESS FIRMLY, PRINT CLEARLY.

WATER WELL RECORD  
KSA 82a-1201-1215

Kansas Department of Health and Environment-Division of Environment  
(Water well Contractors)  
Topeka, Kansas 66620

1. Location of well:	County <b>Stanton</b>	Fraction <b>SE 1/4 Sec 1/NW 1/4</b>	Section number <b>2</b>	Township number <b>T 27 S</b>	Range number <b>R 41 E (W)</b>
2. Distance and direction from nearest town or city: <b>Johnson, Ks. 11 miles north, 1/2 west, 1/2 south</b>			3. Owner of well <b>Dave Weaver</b> R.R. or street: <b>RFD 1</b> City, state, zip code: <b>Milford, Ks. 66514</b>		
4. Locate with "X" in section below: Sketch map: 			6. Bore hole dia. <b>27</b> in. Completion date _____ Well depth <b>612</b> ft. <b>9-19-77</b>		
5. Type and color of material			7. <input type="checkbox"/> Cable tool <input checked="" type="checkbox"/> Rotary <input type="checkbox"/> Driven <input type="checkbox"/> Dug <input type="checkbox"/> Hollow rod <input type="checkbox"/> Jetted <input type="checkbox"/> Bored <input type="checkbox"/> Reverse rotary		
8. Use: <input type="checkbox"/> Domestic <input type="checkbox"/> Public supply <input type="checkbox"/> Industry <input checked="" type="checkbox"/> Irrigation <input type="checkbox"/> Air conditioning <input type="checkbox"/> Stock <input type="checkbox"/> Lawn <input type="checkbox"/> Oil field water <input type="checkbox"/> Other			9. Casing: Material <b>steel</b> Height: <input checked="" type="checkbox"/> Above or below Threaded <input type="checkbox"/> Welded <input checked="" type="checkbox"/> Surface <b>18</b> in. RMP <input type="checkbox"/> PVC <input type="checkbox"/> Weight <b>42.05</b> lbs./ft. Dia. <b>16</b> in. to <b>209.8</b> ft. depth Wall Thickness: inches or Dia. _____ in. to _____ ft. depth gage No. <b>.250</b>		
10. Screen: Manufacturer's name <b>Lakewood Pipe of Texas</b> Type <b>3/16"</b> Dia. <b>16"</b> Slot/gauze <b>3/16"</b> Length <b>242.4'</b> Set between <b>249.8</b> ft. and <b>449.8</b> ft. <b>569.8</b> ft. and <b>612</b> ft. Gravel pack? <input checked="" type="checkbox"/> Size range of material <b>1/4 x 5/8"</b>			11. Static water level: <b>60</b> ft. below land surface Date <b>8-29-77</b> mo./day/yr.		
12. Pumping level below land surfaces: <b>261</b> ft. after <b>24</b> hrs. pumping <b>1070</b> g.p.m. <b>285</b> ft. after <b>26</b> hrs. pumping <b>1236</b> g.p.m. Estimated maximum yield <b>1300</b> g.p.m.			13. Water sample submitted: _____ mo./day/yr. <input type="checkbox"/> Yes <input checked="" type="checkbox"/> No Date _____		
14. Well head completion: <input type="checkbox"/> Pitless adapter <b>18</b> inches above grade			15. Well grouted? <input checked="" type="checkbox"/> With: <input checked="" type="checkbox"/> Neat cement <input type="checkbox"/> Bentonite <input type="checkbox"/> Concrete Depth: From <b>0</b> ft. to <b>10</b> ft.		
16. Nearest source of possible contamination: ft. _____ Direction _____ Type <b>field</b> Well disinfected upon completion? <input type="checkbox"/> Yes <input checked="" type="checkbox"/> No			17. Pump: <input checked="" type="checkbox"/> Not installed Manufacturer's name _____ Model number _____ HP _____ Volts _____ Length of drop pipe _____ ft. capacity _____ g.p.m. Type: <input type="checkbox"/> Submersible <input type="checkbox"/> Turbine <input type="checkbox"/> Jet <input type="checkbox"/> Reciprocating <input type="checkbox"/> Centrifugal <input type="checkbox"/> Other		
18. Elevation: Topography: <input type="checkbox"/> Hill <input checked="" type="checkbox"/> Slope <input type="checkbox"/> Upland <input type="checkbox"/> Valley			19. Remarks: <b>40 feet W. A. Brown Perf. set between 209.8' and 249.8'</b> <b>120 feet W. A. Brown Perf. Set between 449.8' and 569.8'</b>		
20. Water well contractor's certification: This well was drilled under my jurisdiction and this report is true to the best of my knowledge and belief. <b>Houck Bros. Drlg. Co. 164</b> Business name <b>Box 487, Ulysses, Ks.</b> License No. _____ Address _____ Signed <b>M. Beard</b> Date <b>9/23</b> Authorized representative			<div style="font-size: 2em; transform: rotate(90deg); position: absolute; right: -50px; top: 50%; transform: translateY(-50%);">                 27 41 W                  R                  2-SESE                  NW                  1/4 1/4 1/4             </div>		