


USE TYPEWRITER OR BALL POINT PEN-PRESS FIRMLY, PRINT CLEARLY.

WATER WELL RECORD
KSA 82a-1201-1215

Kansas Department of Health and Environment-Division of Environment
(Water well Contractors)
Topeka, Kansas 66620

1. Location of well:	County Stanton	Fraction SW 1/4 SW 1/4 NW 1/4	Section number 5	Township number T 27 S	Range number R 41 E/W
----------------------	--------------------------	---	----------------------------	----------------------------------	---------------------------------

2. Distance and direction from nearest town or city: 11 north, 4 west of Hiway intersection at Johnson, Ks. Street address of well location if in city:	3. Owner of well: H. C. Klassen R.R. or street: RFD 1 City, state, zip code: Kendall, Ks. 67857
--	---

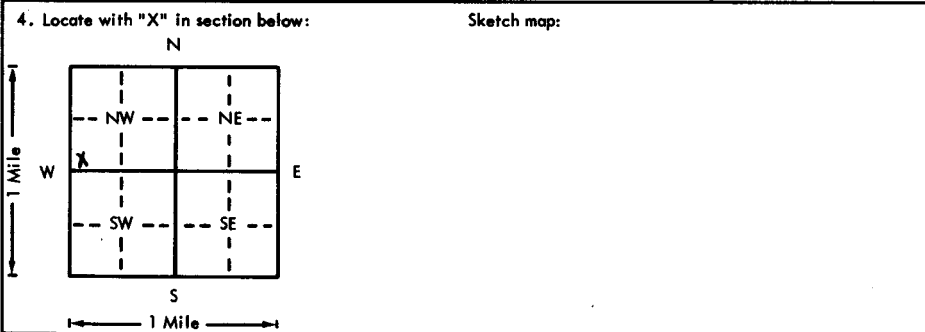

6. Bore hole dia. <u>27</u> in. Completion date <u>8-2-75</u> Well depth <u>571</u> ft.
7. <input checked="" type="checkbox"/> Cable tool <input checked="" type="checkbox"/> Rotary <input type="checkbox"/> Driven <input type="checkbox"/> Dug <input type="checkbox"/> Hollow rod <input type="checkbox"/> Jetted <input type="checkbox"/> Bored <input type="checkbox"/> Reverse rotary
8. Use: <input type="checkbox"/> Domestic <input type="checkbox"/> Public supply <input type="checkbox"/> Industry <input checked="" type="checkbox"/> Irrigation <input type="checkbox"/> Air conditioning <input type="checkbox"/> Stock <input type="checkbox"/> Lawn <input type="checkbox"/> Oil field water <input type="checkbox"/> Other
9. Casing: Material <u>Stl</u> Height: <u>(Above)</u> or below Threaded <input type="checkbox"/> Welded <input checked="" type="checkbox"/> Surface <u>12</u> in. RMP <input type="checkbox"/> PVC <input type="checkbox"/> Weight <u>36.8</u> lbs./ft. Dia. <u>16</u> in. to <u>246.3</u> ft. depth Wall Thickness: <u>inches</u> or Dia. <u>in.</u> to <u>ft.</u> depth Gage No. <u>219</u>

5. Type and color of material	From	To
Surface	0	2
Very fine sand w/clay breakers	2	35
Medium to coarse sand w/clay breakers	35	48
Sandy clay	48	60
Medium to coarse sand w/clay breakers	60	79
Medium to coarse sand w/clay breakers		
Brown clay w/sand strips	79	90
Medium to coarse sand w/clay breakers	90	112
Brown and sandy clay w/coarse sand	112	150
Medium to coarse sand	150	162
Brown & sandy clay	162	188
Brown and blue clay	188	247
Medium to coarse sand w/clay breakers	247	278
Sandrock, white clay & Dakota loose 80%	278	290
Yellow chalk, sandrock, blue shale 15%	290	313
Blue shale & Dakota	313	374
Blue shale, white clay, Dakota & Cheyenne 70%	374	392
Blue shale, white clay, Dakota & Cheyenne 40%	392	420
Brown shale, brown sandrock, Cheyenne & Dakota	420	439
Brown shale, white clay, and brown sandrock, Cheyenne and Dakota sandstone (hard)	439	480
Cheyenne and Dakota sandstone (hard)	480	495
Brown & blue shale, white clay, brown sandrock, Dakota and Cheyenne 40%	495	538
Brown & blue shale, brown sandrock, Dakota & Cheyenne sandstone 80%	538	572
(Use a second sheet if needed)		

10. Screen: Manufacturer's name <u>Lakewood</u> <u>Pipe of Texas</u> Type <u>steel</u> Dia. <u>16 in.</u> Slot/gauze <u>3/16</u> Length <u>294.9 ft.</u> Set between <u>276.3</u> ft. and <u>571</u> ft. ft. and <u>ft.</u> Gravel pack? <u>yes</u> Size range of material <u>1/4 x 5/8</u>
11. Static water level: <u>100</u> ft. below land surface Date <u>8-26-75</u> mo./day/yr.
12. Pumping level below land surfaces: <u>220</u> ft. after <u>8</u> hrs. pumping <u>600</u> g.p.m. <u>240</u> ft. after <u>8</u> hrs. pumping <u>700</u> g.p.m. Estimated maximum yield <u>950</u> g.p.m.
13. Water sample submitted: <u>Yes</u> <input checked="" type="checkbox"/> No <input type="checkbox"/> Date <u>mo./day/yr.</u>
14. Well head completion: <u>Pitless adapter</u> <u>12</u> inches above grade
15. Well grouted? <input checked="" type="checkbox"/> With: <input type="checkbox"/> Neat cement <input checked="" type="checkbox"/> Bentonite <input type="checkbox"/> Concrete Depth: From <u>0</u> ft. to <u>10</u> ft.
16. Nearest source of possible contamination: ft. <u>NA</u> Direction <u>NA</u> Type <u>NA</u> Well disinfected upon completion? <input type="checkbox"/> Yes <input type="checkbox"/> No
17. Pump: <input checked="" type="checkbox"/> Not installed Manufacturer's name _____ Model number _____ HP _____ Volts _____ Length of drop pipe _____ ft. capacity _____ g.p.m. Type: <input type="checkbox"/> Submersible <input type="checkbox"/> Turbine <input type="checkbox"/> Jet <input type="checkbox"/> Reciprocating <input type="checkbox"/> Centrifugal <input type="checkbox"/> Other

18. Elevation: Topography: <input type="checkbox"/> Hill <input checked="" type="checkbox"/> Slope <input type="checkbox"/> Upland <input type="checkbox"/> Valley	19. Remarks: Used 30 feet of Johnson Irrigator Screen set between 246.3 ft. and 276.3 ft.
---	---

20. Water well contractor's certification: This well was drilled under my jurisdiction and this report is true to the best of my knowledge and belief. <u>Houck Bros. Drilling Co. 164</u> Business name <u>Box 487, Ulysses, Ks.</u> License No. _____ Address _____ Signed <u>M. Beard</u> Date <u>11-24-76</u> Authorized representative

277416 - 5 SW SW NW
T
R
Sec