


USE TYPEWRITER OR BALL POINT PEN-PRESS FIRMLY, PRINT CLEARLY.

WATER WELL RECORD
KSA 82a-1201-1215

Kansas Department of Health and Environment-Division of Environment (Water well Contractors) Topeka, Kansas 66620

1. Location of well:	County Stanton	Fraction SW 1/4 SW 1/4 NE 1/4	Section number 6	Township number T 27 S	Range number R 41 E/W
----------------------	--------------------------	-----------------------------------------	----------------------------	----------------------------------	---------------------------------

2. Distance and direction from nearest town or city: 10 north, 4 west, 1/2 north of hiway intersection at Johnson, Ks.	3. Owner of well: Dennis Floyd R.R. or street: 6538 East Exeter City, state, zip code: Scottsdale, Ariz. 85251
---	---

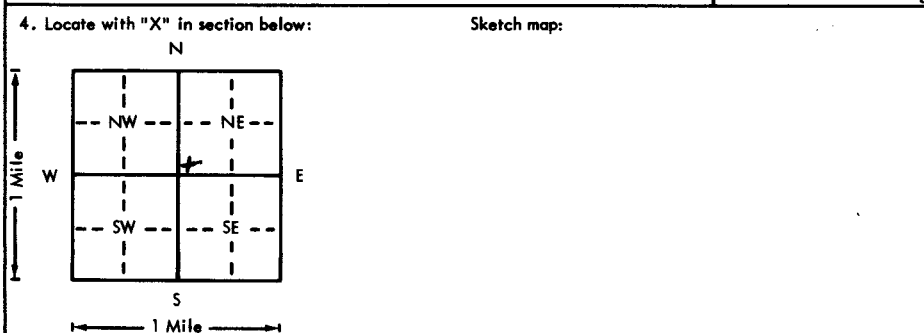

6. Bore hole dia. **27** in. Completion date **10-29-75**
Well depth **467** ft.

7. Cable tool Rotary Driven Dug
 Hollow rod Jetted Bored Reverse rotary

8. Use: Domestic Public supply Industry
 Irrigation Air conditioning Stock
 Lawn Oil field water Other

9. Casing: Material **Stl.** Height **Above** or below
Threaded Welded Surface **12** in.
RMP PVC Weight **36.8** lbs./ft.
Dia. **16** in. to **187** ft. depth Wall Thickness: inches or
Dia. in. to ft. depth Gauge No. **219**

5. Type and color of material	From	To
Surface	0	2
Sandy clay	2	47
Brown clay w/sand strips	47	80
Sandy clay w/clay strips	80	130
Medium to coarse sand	130	140
Sandy clay	140	160
Medium to coarse sand w/clay breakers	160	240
Coarse sand embedded w/clay	240	260
Clay, lime shells, sandstone, sandrock & yellow chalk	260	276
Sandstone	276	325
Sandstone, blue shale	325	340
Sandstone, blue shale	340	413
Sandstone	413	467
(Use a second sheet if needed)		

10. Screen: Manufacturer's name
Lakewood Pipe of Texas
Type **steel** Dia. **16"**
Slot/gauze **3/16"** Length **280 ft.**
Set between **187** ft. and **467** ft.
ft. and _____ ft.
Gravel pack? **yes** Size range of material **1/2 x 5/8"**

11. Static water level:
112.2 ft. below land surface Date **11/3/75** mo./day/yr.

12. Pumping level below land surfaces:
182.7 ft. after **86.7** hrs. pumping **800** g.p.m.
_____ ft. after _____ hrs. pumping _____ g.p.m.
Estimated maximum yield **1500** g.p.m.

13. Water sample submitted: _____ mo./day/yr.
Yes No Date _____

14. Well head completion:
 Pitless adapter **NA** inches above grade

15. Well grouted? **yes**
With: Neat cement Bentonite Concrete
Depth: From **0** ft. to **10** ft.

16. Nearest source of possible contamination:
ft. _____ Direction _____ Type **Field** **NA**
Well disinfected upon completion? Yes No

17. Pump: Not installed
Manufacturer's name _____
Model number _____ HP _____ Volts _____
Length of drop pipe _____ ft. capacity _____ g.p.m.
Type:
 Submersible Turbine
 Jet Reciprocating
 Centrifugal Other

18. Elevation:	19. Remarks:
Topography: <input type="checkbox"/> Hill <input checked="" type="checkbox"/> Slope <input type="checkbox"/> Upland <input type="checkbox"/> Valley	U

20. Water well contractor's certification:
This well was drilled under my jurisdiction and this report is true to the best of my knowledge and belief.
Houck Bros. Drlg. Co. 164
Business name _____ License No. _____
Address **Box 487, Ulysses, Ks.**
Signed **M. Beard** Date **12-10-75**
Authorized representative

27470-6 SW SURVE 1/4 1/4 1/4