


1 LOCATION OF WATER WELL:		Fraction		Section Number		Township Number		Range Number			
County: <u>Stanton</u>		NE 1/4 NW 1/4 NE 1/4		23		T 27 S		R 41 EW			
Distance and direction from nearest town or city street address of well if located within city?											
<u>Approximately 8 miles north & 1/4 mile west of Johnson.</u>											
2 WATER WELL OWNER: <u>Fred Raney Estate & Melvin Winger</u>											
RR#, St. Address, Box # : <u>RR 1</u>											
City, State, ZIP Code : <u>Johnson, Ks. 67855</u>											
Board of Agriculture, Division of Water Resources											
Application Number:											
3 LOCATE WELL'S LOCATION WITH AN "X" IN SECTION BOX:		4 DEPTH OF COMPLETED WELL: <u>275</u> ft. ELEVATION:									
		Depth(s) Groundwater Encountered 1. ft. 2. ft. 3. ft.									
		WELL'S STATIC WATER LEVEL <u>120</u> ft. below land surface measured on mo/day/yr <u>6/2/90</u>									
		Pump test data: Well water was ft. after hours pumping gpm									
		Est. Yield <u>20</u> gpm: Well water was ft. after hours pumping gpm									
		Bore Hole Diameter <u>9 7/8</u> in. to <u>275</u> ft., and in. to ft.									
WELL WATER TO BE USED AS:											
<div style="display: flex; justify-content: space-between;"> 5 Public water supply 8 Air conditioning 11 Injection well </div> <div style="display: flex; justify-content: space-between;"> 1 Domestic 3 Feedlot 6 Oil field water supply 9 Dewatering 12 Other (Specify below) </div> <div style="display: flex; justify-content: space-between;"> 2 Irrigation 4 Industrial 7 Lawn and garden only 10 Monitoring well </div>											
Was a chemical/bacteriological sample submitted to Department? Yes No <u>X</u> ; If yes, mo/day/yr sample was submitted											
Water Well Disinfected? Yes <u>X</u> No											
5 TYPE OF BLANK CASING USED:											
<div style="display: flex; justify-content: space-between;"> 1 Steel 3 RMP (SR) 5 Wrought iron 8 Concrete tile CASING JOINTS: Glued <u>X</u> Clamped </div> <div style="display: flex; justify-content: space-between;"> 2 PVC 4 ABS 6 Asbestos-Cement 9 Other (specify below) Welded </div> <div style="display: flex; justify-content: space-between;"> 7 Fiberglass Threaded </div>											
Blank casing diameter 5 in. to 275 ft., Dia in. to ft., Dia in. to ft.											
Casing height above land surface 12 in., weight 2.9 lbs./ft. Wall thickness or gauge No. 265											
TYPE OF SCREEN OR PERFORATION MATERIAL:											
<div style="display: flex; justify-content: space-between;"> 1 Steel 3 Stainless steel 5 Fiberglass 7 PVC 10 Asbestos-cement </div> <div style="display: flex; justify-content: space-between;"> 2 Brass 4 Galvanized steel 6 Concrete tile 8 RMP (SR) 11 Other (specify) </div> <div style="display: flex; justify-content: space-between;"> 9 ABS 12 None used (open hole) </div>											
SCREEN OR PERFORATION OPENINGS ARE:											
<div style="display: flex; justify-content: space-between;"> 1 Continuous slot 3 Mill slot 5 Gauzed wrapped 8 Saw cut 11 None (open hole) </div> <div style="display: flex; justify-content: space-between;"> 2 Louvered shutter 4 Key punched 6 Wire wrapped 9 Drilled holes </div> <div style="display: flex; justify-content: space-between;"> 7 Torch cut 10 Other (specify) </div>											
SCREEN-PERFORATED INTERVALS: From 155 ft. to 275 ft., From ft. to ft.											
GRAVEL PACK INTERVALS: From 25 ft. to 275 ft., From ft. to ft.											
6 GROUT MATERIAL: 1 Neat cement 2 Cement grout 3 Bentonite 4 Other											
Grout Intervals: From 5 ft. to 25 ft., From ft. to ft., From ft. to ft.											
What is the nearest source of possible contamination:											
<div style="display: flex; justify-content: space-between;"> 1 Septic tank 4 Lateral lines 7 Pit privy 10 Livestock pens 14 Abandoned water well </div> <div style="display: flex; justify-content: space-between;"> 2 Sewer lines 5 Cess pool 8 Sewage lagoon 11 Fuel storage 15 Oil well/Gas well </div> <div style="display: flex; justify-content: space-between;"> 3 Watertight sewer lines 6 Seepage pit 9 Feedyard 12 Fertilizer storage 16 Other (specify below) </div> <div style="display: flex; justify-content: space-between;"> 13 Insecticide storage </div>											
Direction from well? <u>Northwest</u> How many feet? <u>60</u>											
FROM		TO		LITHOLOGIC LOG		FROM		TO		PLUGGING INTERVALS	
				<u>See attached log</u>							
7 CONTRACTOR'S OR LANDOWNER'S CERTIFICATION: This water well was (1) constructed, (2) reconstructed, or (3) plugged under my jurisdiction and was completed on (mo/day/year) <u>June 2, 1990</u> and this record is true to the best of my knowledge and belief. Kansas Water Well Contractor's License No. <u>145</u> This Water Well Record was completed on (mo/day/yr) <u>June 12, 1990</u> under the business name of <u>Henkle Drilling & Supply Co., Inc.</u> by (signature) <u>Benny Richman</u>											
INSTRUCTIONS: Use typewriter or ball point pen. PLEASE PRESS FIRMLY and PRINT clearly. Please fill in blanks, underline or circle the correct answers. Send top three copies to Kansas Department of Health and Environment, Bureau of Water, Topeka, Kansas 66620-7320. Telephone: 913-296-5545. Send one to WATER WELL OWNER and retain one for your records.											

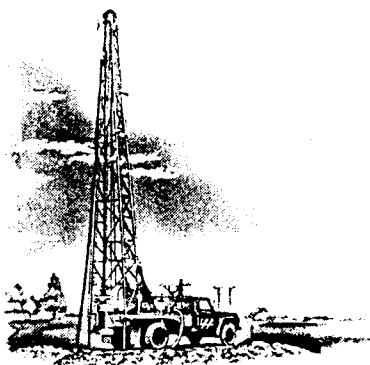

Henkle

DRILLING & SUPPLY CO., INC.

3795 W. JONES AVE.
316/277-2389
FAX/277-0224

P.O. Box 639
GARDEN CITY, KANSAS 67846

CUSTOMER'S NAME Fred Raney Estate & Melvin Winger DATE June 2, 1990
STREET ADDRESS RR 1 TEST # 1 E. LOG No
CITY & STATE Johnson, Ks. 67855 DRILLER Wildeman
COUNTY Stanton QUARTER NE SECTION 23 TOWNSHIP 27 RANGE 41

LOCATION 45' east & 80' south of old well

%	FOOTAGE			DESCRIPTION OF STRATA	STATIC WATER LEVEL: Approx. 120'	
	From	Pay	To		Proposed Well Depth:	275'
	0		2	Top soil		
	2		20	Brown sandy clay & few coarse gravel layers mixed		
	20		30	Brown sandy clay		
	30		38	Brown clay		
	38		50	Sand fine to medium & sandy clay mixed		
	50		65	Sand fine to medium coarse small to medium gravel (loose) Used a little water		
	65		77	Sand fine to medium coarse small to medium gravel some large (used a little water)		
	77		82	Brown & gray clay		
	82		91	Sand fine to medium coarse small gravel		
	91		101	Brown sandy clay & few sand streaks		
	101		125	Sand fine to medium coarse small gravel & few clay streaks		
	125		136	Sand fine to medium coarse small to large gravel		
	136		141	Brown clay		
55	141	09	150	Sand fine to medium coarse very few small gravel & clay mixed		
	150		157	Brown sandy clay & few ledges		
65	157	27	184	Sand fine to medium coarse very few small gravel & tiny white & brown rock (used lots of water) few clay streaks		
	184		192	Brown & gray clay		
	192		194	Limerock		
65	194	12	206	Sand fine to medium coarse small gravel		
	206		221	Brown clay		
65	221	04	225	Sand fine to medium coarse tiny white & brown rock		
	225		235	Brown sandy clay & few sand streaks		
	235		245	Brown clay		
	245		250	Soapstone		
30	250	13	263	Sandstone & few soapstone streaks		
	263		285	Soapstone & few sandstone streaks		
	285		291	Sandstone (lost circulation at 287')		
				Well depth = 275'		
				10 - Sacks of Quick Gel		
				14 - Sacks of Hole Plug		
				6 - Centralizers		
				5 - Tons of #1 Fine	2 - 5" caps	
				120' - of 5" perf		
				155' - of 5" Plain		