

USE TYPEWRITER OR BALL POINT PEN—PRESS FIRMLY, PRINT CLEARLY.

T R EW sec 1/4 1/4 1/4 No.


WATER WELL RECORD  
KSA 82a-1201-1215

Kansas State Dept. Of Health  
(Water Well Contractors)  
Forbes-Bldg. 740  
Topeka, Kansas 66620

1 Location of well:	County <b>Stanton</b>	Township name <b>Stanton</b>	Fraction <b>NE 1/4 NE 1/4 SE 1/4</b>	Section number <b>27</b>	Town number <b>27 S</b>	Range number <b>41 W</b>
---------------------	--------------------------	---------------------------------	---	-----------------------------	----------------------------	-----------------------------

Distance and direction from nearest town or city: **6 1/2 miles N., 1 W of Johnson, Kansas**  
Street address of well location if in city:

3 Owner of well: **H & C. Farms, Inc.**  
Address: **Johnson, Kansas**

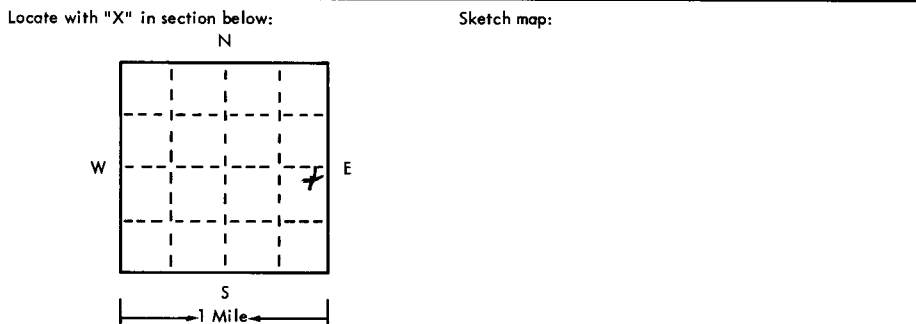

4 Well depth: **311.4** ft. Date of completion **3/5/75**  
Well diameter **27** in.

5  Cable tool  Rotary  Driven  Dug  
 Hollow rod  Jetted  Bored  Reverse rotary

6 Use:  Domestic  Public supply  Industry  
 Irrigation  Air conditioning  Commercial  
 Test well

7 Casing: Material \_\_\_\_\_ Height:  above  below  
Threaded  Welded  Surface **12** in.  
Diam. \_\_\_\_\_ Weight **36.8** lbs./ft. **1**  
\_\_\_\_\_ in. to \_\_\_\_\_ ft. depth Drive shoe?  Yes  No  
\_\_\_\_\_ in. to \_\_\_\_\_ ft. depth

2	Type and color of material	From	To
	Surface	0	2
	Medium sand w/clay breakers	2	45
	Coarse sand	45	60
	Brown clay	60	100
	Coarse sand w/small clay breakers	100	120
	Brown clay w/small sand strips	120	170
	Coarse sand 40 ft.	170	210
	Medium sand, some fine 11 ft.	210	221
	Sandy clay	221	237
	Medium sand w/clay breakers 28 ft.	237	292
	Coarse sand	292	302
	Yellow & gray shale w/sandstone (tight)	302	315

8 Screen: **Johnson Irrigator**  
Manufacturer **Lakewood Perf.**  
Type **steel and gal. steel 16"** O.D.  
Slot/gauge **3/16" 29%** Length **2" slot**  
Jet between \_\_\_\_\_ ft. and \_\_\_\_\_ ft. \_\_\_\_\_  
Fittings:  
Gravel pack  Yes  No Size range of material **1/4 - 3/8**

9 Static water level:  
**125** ft. below land surface Date **3/3/75**

10 Pumping level below land surfaces:  
**177** ft. after **24** hrs. pumping **2200** g.p.m.  
\_\_\_\_\_ ft. after \_\_\_\_\_ hrs. pumping \_\_\_\_\_ g.p.m.  
Estimated maximum yield **2600** g.p.m.

11 Water sample submitted:  
 Yes  No Date \_\_\_\_\_

12 Well head completion:  
 Pitless adapter  Inches above grade

13 Well grouted?  Yes  No  
 Neat cement  Bentonite  \_\_\_\_\_  
Depth: From **0** ft. to **10** ft.

14 Nearest source of possible contamination:  
ft. **5 M.** Direction **North** Type **farm site**  
Well disinfected upon completion?  Yes  No

15 Pump:  Not installed  
Manufacturer's name \_\_\_\_\_  
Model number \_\_\_\_\_ HP \_\_\_\_\_ Volts \_\_\_\_\_  
Length of drop pipe \_\_\_\_\_ ft. capacity \_\_\_\_\_ g.p.m.  
Type:  
 Submersible  Turbine  
 Jet  Reciprocating  
 Centrifugal  Other

16 Remarks: elevation  
~~Plain casing 16" O.D. steel set from 0 to 198.4~~  
**Johnson Screen 16" o.d. gal. steel set from 198.4 to 218.4**  
**Lakewood Perf. 16" O.D. steel set from 218.4 to 288.4**  
**Johnson Screen 16" O.D. gal. steel set from 288.4 to 298.4**  
**Lakewood Perf. 16" O.D steel set from 298.4 to 311.4**  
Topography:  
 Upland  
 Slope  
 Valley  
**Drilled in summer fallowed land**

Water well contractor's certification:  
This well was drilled under my jurisdiction and this report is true to the best of my knowledge and belief.  
**Houck Bros. Drilling Co.** 164  
Business name \_\_\_\_\_ License No. \_\_\_\_\_  
Address **Box 487, Ulysses, Kansas**  
Signed **M. Beard** Date **3/31/75**  
Authorized representative