

**WATER WELL RECORD**

**Form WWC-5**

Division of Water Resources App. No.


9128

<b>1 LOCATION OF WATER WELL:</b> County: <u>Stanton</u>	Fraction <u>1/4 NW 1/4 SW 1/4 NW 1/4</u>	Section Number <u>6</u>	Township No. <u>T 27 S</u>	Range Number <u>R 42</u> <input type="checkbox"/> E <input checked="" type="checkbox"/> W
--	---	----------------------------	-------------------------------	--

Street/Rural Address of Well Location; if unknown, distance & direction from nearest town or intersection: If at owner's address, check here   
Johnson 10 North 11 West 1/2 North 1/4 East

**Global Positioning System (GPS) information:**  
 Latitude: ..... (in decimal degrees)  
 Longitude: ..... (in decimal degrees)  
 Elevation: .....  
 Datum:  WGS 84,  NAD 83,  NAD 27  
 Collection Method:  
 GPS unit (Make/Model: .....)  
 Digital Map/Photo,  Topographic Map,  Land Survey  
 Est. Accuracy:  <3 m,  3-5 m,  5-15 m,  >15 m

**2 WATER WELL OWNER:** Grady Cook  
 RR#, Street Address, Box #: 12500 W Road 1  
 City, State, ZIP Code : Svracuse. KS 67878

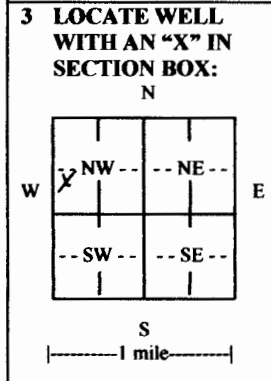

**4 DEPTH OF COMPLETED WELL** 630 ft.  
 Depth(s) Groundwater Encountered (1) 265 ft. (2)..... ft. (3)..... ft.  
 WELL'S STATIC WATER LEVEL.....ft. below land surface measured on mo/day/yr.....  
 Pump test data: Well water was.....ft. after..... hours pumping..... gpm  
 EST. YIELD.....gpm. Well water was.....ft. after..... hours pumping..... gpm  
 Bore Hole Diameter 26 in. to 630 ft., and .....in. to .....ft.  
 WELL WATER TO BE USED AS:  Public water supply  Geothermal  Injection well  
 Domestic  Feedlot  Oil field water supply  Dewatering  Other (Specify below)  
 Irrigation  Industrial  Domestic-lawn & garden  Monitoring well .....  
 Was a chemical/bacteriological sample submitted to Department?  Yes  No  
 If yes, mo/day/yr sample was submitted.....  
 Water well disinfected?  Yes  No

**5 TYPE OF CASING USED:**  Steel  PVC  Other .....  
 CASING JOINTS:  Glued  Clamped  Welded  Threaded  
 Casing diameter .16 in. to 630 ft., Diameter ..... in. to ..... ft., Diameter ..... in. to ..... ft.  
 Casing height above land surface 12 in., Weight .....lbs./ft., Wall thickness or gauge No. .025  
 TYPE OF SCREEN OR PERFORATION MATERIAL:  
 Steel  Stainless Steel  PVC  Other (Specify) .....  
 Brass  Galvanized Steel  None used (open hole)  
 SCREEN OR PERFORATION OPENINGS ARE:  
 Continuous slot  Mill slot  Gauze wrapped  Torch cut  Drilled holes  None (open hole)  
 Louvered shutter  Key punched  Wire wrapped  Saw cut  Other (specify) .....  
 SCREEN-PERFORATED INTERVALS: From 310 ft. to 350 ft., From 430 ft. to 470 ft.  
 From 510 ft. to 550 ft., From 590 ft. to 630 ft.  
 GRAVEL PACK INTERVALS: From 20 ft. to 630 ft., From ..... ft. to ..... ft.  
 From ..... ft. to ..... ft., From ..... ft. to ..... ft.

**6 GROUT MATERIAL:**  Neat cement  Cement grout  Bentonite  Other .....  
 Grout Intervals: From 0 ft. to 20 ft., From ..... ft. to ..... ft., From ..... ft. to ..... ft.  
 What is the nearest source of possible contamination:  
 Septic tank  Lateral lines  Pit privy  Livestock pens  Insecticide storage  Other (specify below)  
 Sewer lines  Cesspool  Sewage lagoon  Fuel storage  Abandoned water well  
 Watertight sewer lines  Seepage pit  Feedyard  Fertilizer storage  Oil well/gas well .....  
 Direction from well NA..... Distance from well .....

FROM	TO	LITHOLOGIC LOG	FROM	TO	LITHO. LOG (cont.) or PLUGGING INTERVALS
		See Attached			

**7 CONTRACTOR'S OR LANDOWNER'S CERTIFICATION:** This water well was  constructed,  reconstructed, or  plugged under my jurisdiction and was completed on (mo/day/year) 12/15/10..... and this record is true to the best of my knowledge and belief.  
 Kansas Water Well Contractor's License No. 473..... This Water Well Record was completed on (mo/day/year) 12/10/11.....  
 under the business name of Tyler Water Well Inc...... by (signature).....

**INSTRUCTIONS:** Use typewriter or ball point pen. PLEASE PRESS FIRMLY and PRINT clearly. Please fill in blanks and check the correct answers. Send three copies (white, blue, pink) to Kansas Department of Health and Environment, Bureau of Water, Geology Section, 1000 SW Jackson St., Suite 426, Topeka, Kansas 66612-1367. Telephone 785-296-5522. Send one copy to WATER WELL OWNER and retain one for your records. Include fee of \$5.00 for each constructed well. Visit us at <http://www.kdheks.gov/waterwell/index.html>.

Tyler Water Well Service  
 5730 North 3<sup>rd</sup> Street  
 Garden City, Ks 67846

### TEST HOLE REPORT

Contact Name Grady Cook  
 Test Hole Number \_\_\_\_\_  
 City Syracuse State KS 67878 Driller Clint  
 Test Hole Location 1/2 Mile North East of Well  
Distance and Direction from Permanent Landmark or Previous Test Hole

#### TEST LOG

Approximate Static Water Level 265 Measured

FROM	TO	FORMATION	FAIR	GOOD	FROM	TO	FORMATION	FAIR	GOOD
0	5	Topsoil and Sandy Clay							
5	8	Fine Sand							
8	17	White Sandy Clay							
17	37	Sand & Gravel							
37	56	Brown Clay							
56	60	Red Sandy Clay							
60	69	Red Sand							
69	86	Yellow Sandy Clay & Cliché							
86	92	Sand Medium to Coarse							
92	100	Cliché							
100	107	Sandy Clay and Cliché							
107	117	Sand Fine							
117	128	Sandy Clay							
128	140	Sand with Little Clay							
140	170	Sandy Clay							
170	220	Sandy Clay and Sand Mix							
220	250	Sand Med to Cr. Little Clay							
250	258	Clay							
258	260	Sand							
260	270	Clay							
270	280	Sand Little Clay							
280	330	Sandstone Little clay	41						
330	340	Shale							
340	380	Shale (hard)							
380	385	Rock (hard)							
385	440	Shale and Little Sand Stone	25						
440	460	White Sand Stone		15					
460	475	Brown Sand Stone		12					
475	480	Shale							
480	515	Brown Sand Stone Lt Shale		28					
515	520	Red Shale							
520	600	White & Red Sand Stone Lt Shale		47					
600	630	Wht/Red Sandstone Lt Shale		30					

Notes: Size of Pit \_\_\_\_\_ x \_\_\_\_\_ x \_\_\_\_\_ Deep \_\_\_\_\_

\_\_\_\_\_  
 \_\_\_\_\_  
 \_\_\_\_\_