


1 LOCATION OF WATER WELL: Stanton
 County: Stanton
 Fraction NW 1/4 NE 1/4 NE 1/4
 Section Number 9
 Township Number T 27 S
 Range Number R 43 EW

Distance and direction from nearest town or city street address of well if located within city?
 14 miles west and 10 north of Johnson, Kansas

2 WATER WELL OWNER: Seaboard Farms, Inc. Well #1 on G-S Cook
 RR#, St. Address, Box #: P. O. Box 1029 Board of Agriculture, Division of Water Resources
 City, State, ZIP Code: Hugoton, Kansas 67951 Application Number:

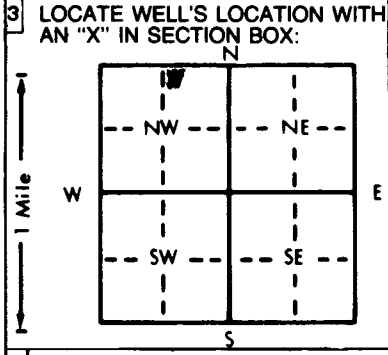

4 DEPTH OF COMPLETED WELL: 398 ft. ELEVATION: slope
 Depth(s) Groundwater Encountered 1. 243 ft. 2. ft. 3. ft.
 WELL'S STATIC WATER LEVEL 243 ft. below land surface measured on mo/day/yr 7/31/95
 Pump test data: Well water was Pump set by E.N. Pumped ft. after hours pumping gpm
 Est. Yield gpm: Well water was after hours pumping gpm
 Bore Hole Diameter 14 1/2 in. to 398 ft., and in. to ft.
 WELL WATER TO BE USED AS:
 1 Domestic 3 Feedlot 6 Oil field water supply 9 Dewatering 12 Other (Specify below)
 2 Irrigation 4 Industrial 7 Lawn and garden only 10 Monitoring well
 Was a chemical/bacteriological sample submitted to Department? Yes No X; If yes, mo/day/yr sample was submitted
 Water Well Disinfected? Yes X No

5 TYPE OF BLANK CASING USED:
 1 Steel 3 RMP (SR) 6 Asbestos-Cement 9 Other (specify below) Welded
 2 PVC 4 ABS 7 Fiberglass Threaded
 Blank casing diameter 8 in. to 29.2 ft., Dia 8 in. to 33.8 ft., Dia in. to ft.
 Casing height above land surface 19 in., weight Schedule 200 SDR 13.5 ft. Wall thickness or gauge No.
 TYPE OF SCREEN OR PERFORATION MATERIAL:
 1 Steel 3 Stainless steel 5 Fiberglass 8 RMP (SR) 10 Asbestos-cement
 2 Brass 4 Galvanized steel 6 Concrete tile 9 ABS 11 Other (specify)
 12 None used (open hole)
 SCREEN OR PERFORATION OPENINGS ARE:
 1 Continuous slot 3 Mill slot 6 Wire wrapped 8 Saw cut 11 None (open hole)
 2 Louvered shutter 4 Key punched 7 Torch cut 9 Drilled holes 10 Other (specify)
 SCREEN-PERFORATED INTERVALS: From 29.2 ft. to 31.2 ft., From 33.8 ft. to 39.8 ft.
 From ft. to ft., From ft. to ft.
 GRAVEL PACK INTERVALS: From 24 ft. to 39.8 ft., From ft. to ft.
 From ft. to ft., From ft. to ft.

6 GROUT MATERIAL: 1 Neat cement 2 Cement grout 3 Bentonite 4 Other
 Grout Intervals: From 4 ft. to 24 ft., From ft. to ft., From ft. to ft.
 What is the nearest source of possible contamination:
 1 Septic tank 4 Lateral lines 7 Pit privy 10 Livestock pens 14 Abandoned water well
 2 Sewer lines 5 Cess pool 8 Sewage lagoon 11 Fuel storage 15 Oil well/Gas well
 3 Watertight sewer lines 6 Seepage pit 9 Feedyard 12 Fertilizer storage 16 Other (specify below)
 13 Insecticide storage
 Direction from well? West How many feet? 1300

FROM	TO	LITHOLOGIC LOG	FROM	TO	PLUGGING INTERVALS
0	2	Surface			
2	10	Sandy clay			
10	100	Medium to coarse sand w/clay breakers			
100	124	Fine to medium sand w/clay breakers			
124	210	Fine to medium sand w/cemented strips			
210	260	Medium sand			
260	283	Medium to coarse sand w/clay breakers			
283	317	Shale & hard sandrock			
317	364	Brown and red shale w/sandstone strips			
364	385	Sandstone			
385	395	Shale w/small sandstone strips			
395	499	Shale			

7 CONTRACTOR'S OR LANDOWNER'S CERTIFICATION: This water well was (1) constructed, (2) reconstructed, or (3) plugged under my jurisdiction and was completed on (mo/day/year) 7/31/95 and this record is true to the best of my knowledge and belief. Kansas
 Water Well Contractor's License No. 164 This Water Well Record was completed on (mo/day/yr) 8/21/95
 under the business name of Houck Bros. Drilling Co. by (signature) M. Beard

INSTRUCTIONS: Use typewriter or ball point pen. PLEASE PRESS FIRMLY and PRINT clearly. Please fill in blanks, underline or circle the correct answers. Send top three copies to Kansas Department of Health and Environment, Bureau of Water, Topeka, Kansas 66620-0001. Telephone: 913-296-5545. Send one to WATER WELL OWNER and retain one for your records.