


1 LOCATION OF WATER WELL: County: STANTON Fraction SW 1/4 SW 1/4 SW 1/4 Section Number 9 Township Number T 27 S Range Number R 43 EW

Distance and direction from nearest town or city street address of well if located within city?  
9 miles north--15 miles west of Johnson, Ks.

2 WATER WELL OWNER: RR#, St. Address, Box #: Grady Cook Board of Agriculture, Division of Water Resources City, State, ZIP Code: South Route, Box 33, Syracuse, Ks. 67878 Application Number: 36618

3 LOCATE WELL'S LOCATION WITH AN "X" IN SECTION BOX:

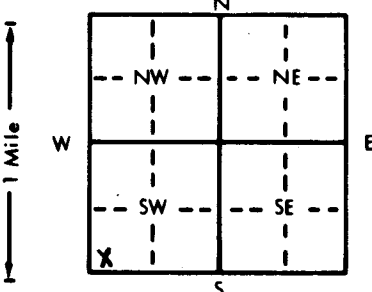

4 DEPTH OF COMPLETED WELL: 401.3 ft. ELEVATION: slope  
 Depth(s) Groundwater Encountered 1. 210 ft. 2. ft. 3. ft.  
 WELL'S STATIC WATER LEVEL: 210 ft. below land surface measured on mo/day/yr July 2, 1984  
 Pump test data: Well water was ft. after hours pumping gpm  
 Est. Yield gpm: Well water was ft. after hours pumping gpm  
 Bore Hole Diameter: .26 in. to .401.3 ft., and in. to ft.  
 WELL WATER TO BE USED AS:  
 5 Public water supply 8 Air conditioning 11 Injection well  
 1 Domestic 3 Feedlot 6 Oil field water supply 9 Dewatering 12 Other (Specify below)  
 2 Irrigation 4 Industrial 7 Lawn and garden only 10 Observation well  
 Was a chemical/bacteriological sample submitted to Department? Yes No ; If yes, mo/day/yr sample was submitted  
 Water Well Disinfected? Yes No

5 TYPE OF BLANK CASING USED:  
 1 Steel 3 RMP (SR) 5 Wrought iron 8 Concrete tile CASING JOINTS: Glued Clamped  
 2 PVC 4 ABS 6 Asbestos-Cement 9 Other (specify below) Welded   
 7 Fiberglass Threaded  
 Blank casing diameter: 16 in. to 241.3 ft., Dia in. to ft., Dia in. to ft.  
 Casing height above land surface: 16 in., weight 36.85 lbs./ft. Wall thickness or gauge No. 219  
 TYPE OF SCREEN OR PERFORATION MATERIAL:  
 1 Steel 3 Stainless steel 5 Fiberglass 7 PVC 10 Asbestos-cement  
 2 Brass 4 Galvanized steel 6 Concrete tile 8 RMP (SR) 11 Other (specify)  
 9 ABS 12 None used (open hole)  
 SCREEN OR PERFORATION OPENINGS ARE:  
 1 Continuous slot 3 Mill slot 5 Gauzed wrapped 8 Saw cut 11 None (open hole)  
 2 Louvered shutter 4 Key punched 6 Wire wrapped 9 Drilled holes  
 7 Torch cut 10 Other (specify)  
 SCREEN-PERFORATED INTERVALS: From 241.3 ft. to 401.3 ft., From ft. to ft.  
 GRAVEL PACK INTERVALS: From 10 ft. to 40;3 ft., From ft. to ft.

6 GROUT MATERIAL: 1 Neat cement 2 Cement grout 3 Bentonite 4 Other  
 Grout Intervals: From 0 ft. to 10 ft., From ft. to ft., From ft. to ft.  
 What is the nearest source of possible contamination:  
 1 Septic tank 4 Lateral lines 7 Pit privy 10 Livestock pens 14  
 2 Sewer lines 5 Cess pool 8 Sewage lagoon 11 Fuel storage 15 Oil well/Gas well  
 3 Watertight sewer lines 6 Seepage pit 9 Feedyard 12 Fertilizer storage 16 Other (specify below)  
 13 Insecticide storage ~~17~~ field  
 Direction from well? How many feet?

FROM	TO	LITHOLOGIC LOG	FROM	TO	LITHOLOGIC LOG
0	2	Surface			
2	17	Clay and fine sand			
17	75	Sandy clay and fine sand			
75	268	Fine sand some medium			
268	300	Sandrock and sandstone			
300	335	Blue shale and sandstone			
335	395	Sandstone			
395	405	Shale			

7 CONTRACTOR'S OR LANDOWNER'S CERTIFICATION: This water well was (1) constructed, (2) reconstructed, or (3) plugged under my jurisdiction and was completed on (mo/day/year) July 2, 1984 and this record is true to the best of my knowledge and belief. Kansas Water Well Contractor's License No. 164 This Water Well Record was completed on (mo/day/yr) Aug 17, 1985 under the business name of HOUCK BROS. DRILLING CO. by (signature) M. Beard

INSTRUCTIONS: Use typewriter or ball point pen, PLEASE PRESS FIRMLY and PRINT clearly. Please fill in blanks, underline or circle the correct answers. Send top three copies to Kansas Department of Health and Environment, Division of Environment, Environmental Geology Section, Topeka, KS 66620. Send one to WATER WELL OWNER and retain one for your records.