


1 LOCATION OF WATER WELL: County: STANTON Fraction NE $\frac{1}{4}$ LOT SE $\frac{1}{4}$ NE $\frac{1}{4}$ Section Number 8 Township Number T 27 S Range Number R 43 E/W

Distance and direction from nearest town or city street address of well if located within city?
 12 MILES NORTHWEST OF JOHNSON, KANSAS.

2 WATER WELL OWNER: SUPERIOR FARMS, L.L.C.
 RR#, St. Address, Box #: 830 COUNTRY ESTATES ROAD, P.O. BOX 2557 Board of Agriculture, Division of Water Resources
 City, State, ZIP Code: LIBERAL, KS 67905 Application Number: 36,618-ST

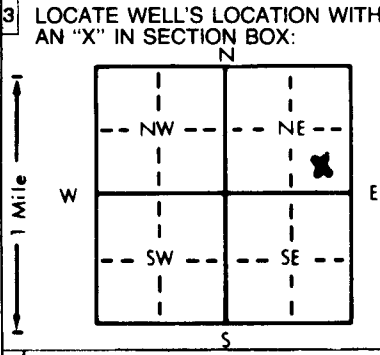

4 DEPTH OF COMPLETED WELL: 402 ft. ELEVATION:
 Depth(s) Groundwater Encountered 1. ft. 2. ft. 3. ft.
 WELL'S STATIC WATER LEVEL 245 ft. below land surface measured on mo/day/yr 2/23/95
 Pump test data: Well water was ft. after hours pumping gpm
 Est. Yield gpm: Well water was ft. after hours pumping gpm
 Bore Hole Diameter: ~~30~~ 14-3/4 in. to 402 ft., and in. to ft.
 WELL WATER TO BE USED AS:
 5 Public water supply 8 Air conditioning 11 Injection well
 1 Domestic 3 Feedlot 6 Oil field water supply 9 Dewatering 12 Other (Specify below)
~~4 Industrial~~ 7 Lawn and garden only 10 Monitoring well
 Was a chemical/bacteriological sample submitted to Department? Yes No X If yes, mo/day/yr sample was submitted
 Water Well Disinfected? Yes No

5 TYPE OF BLANK CASING USED:
1 Steel 3 RMP (SR) 5 Wrought iron 8 Concrete tile CASING JOINTS: Glued Clamped
 2 PVC 4 ABS 6 Asbestos-Cement 9 Other (specify below) Welded X
 7 Fiberglass Threaded
 Blank casing diameter 8 in. to 402 ft., Dia in. to ft., Dia in. to ft.
 Casing height above land surface: ~~2~~ 2 in., weight 32 lbs./ft. Wall thickness or gauge No. .060
 TYPE OF SCREEN OR PERFORATION MATERIAL:
1 Steel 3 Stainless steel 5 Fiberglass 8 RMP (SR) 10 Asbestos-cement
 2 Brass 4 Galvanized steel 6 Concrete tile 9 ABS 12 None used (open hole)
 SCREEN OR PERFORATION OPENINGS ARE:
 1 Continuous slot 3 Mill slot 5 Gauzed wrapped 8 Saw cut 11 None (open hole)
 2 Louvered shutter 4 Key punched 6 Wire wrapped 9 Drilled holes
 7 Torch cut 10 Other (specify)
 SCREEN-PERFORATED INTERVALS: From 282 ft. to 342 ft., From 362 ft. to 402 ft.
 From ft. to ft., From ft. to ft.
 GRAVEL PACK INTERVALS: From ~~28~~ 30 ft. to 402 ft., From ft. to ft.
 From ft. to ft., From ft. to ft.

6 GROUT MATERIAL: 1 Neat cement 2 Cement grout 3 Bentonite 4 Other
 Grout Intervals: From 0 ft. to ~~28~~ 30 ft., From ft. to ft., From ft. to ft.
 What is the nearest source of possible contamination:
 1 Septic tank 4 Lateral lines 7 Pit privy 10 Livestock pens 14 Abandoned water well
 2 Sewer lines 5 Cess pool 8 Sewage lagoon 11 Fuel storage 15 Oil well/Gas well
 3 Watertight sewer lines 6 Seepage pit 9 Feedyard 12 Fertilizer storage 16 Other (specify below)
 13 Insecticide storage

Direction from well? How many feet?

FROM	TO	LITHOLOGIC LOG	FROM	TO	PLUGGING INTERVALS
0	10	SURFACE			
10	24	CLAY & SANDY CLAY			
24	47	SAND MED. GRAIN CLAY STKS.			
47	143	CLAY & SANDY CLAY			
143	274	SAND FEW CLAY STKS. MED. & COARSE GRAIN			
274	293	SAND & SMALL GRAVEL MOSTLY CLEAN			
293	326	TAN SANDROCK MED. GRAIN			
326	335	BLUE SHALE			
335	353	GRAY SANDROCK MED. GRAIN			
353	390	TAN SANDROCK MED. GRAIN			
390	420	GRAY SANDROCK MED. GRAIN			

7 CONTRACTOR'S OR LANDOWNER'S CERTIFICATION: This water well was (1) constructed, (2) reconstructed, or (3) plugged under my jurisdiction and was completed on (mo/day/year) 2/20/95 and this record is true to the best of my knowledge and belief. Kansas Water Well Contractor's License No. 225 This Water Well Record was completed on (mo/day/yr) 4/12/95 under the business name of KTM DRILLING, INC. by (signature) *[Signature]*

INSTRUCTIONS: Use typewriter or ball point pen. PLEASE PRESS FIRMLY and PRINT clearly. Please fill in blanks, underline or circle the correct answers. Send top three copies to Kansas Department of Health and Environment, Bureau of Water, Topeka, Kansas 66620-0001. Telephone: 913-296-5545. Send one to WATER WELL OWNER and retain one for your records.