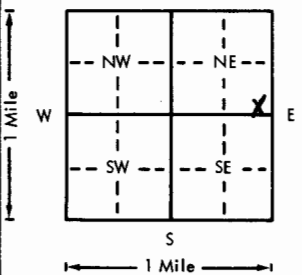


USE TYPEWRITER OR BALL
POINT PEN-PRESS FIRMLY,
PRINT CLEARLY.

WATER WELL RECORD
KSA 82a-1201-1215

Kansas Department of Health and
Environment-Division of Environment
(Water well Contractors)
Topeka, Kansas 66620

1. Location of well:		County: <u>Kingman</u>	Fraction: <u>1/4 SE 1/4 NE 1/4</u>	Section number: <u>2</u>	Township number: <u>T 27</u>	Range number: <u>S 5 E 10</u>
2. Distance and direction from nearest town or city: <u>approx. 3/4 E. & 1/4 No. of Mt. Vernon, Mo.</u>		3. Owner of well: <u>C. Robert Bell</u> R.R. or street: <u>Suite 790 Century Plaza Bldg.</u> City, state, zip code: <u>Wichita, Kansas</u>				
4. Locate with "X" in section below:		Sketch map: <u>Mt. Vernon, Mo.</u>				
						
5. Type and color of material		From	To	6. Bore hole dia. <u>12</u> in. Completion date <u>2-12-76</u> Well depth <u>50</u> ft.		
<u>Topsoil</u>		<u>0</u>	<u>3</u>	7. <input checked="" type="checkbox"/> Cable tool <input checked="" type="checkbox"/> Rotary <input type="checkbox"/> Driven <input type="checkbox"/> Dug <input type="checkbox"/> Hollow rod <input type="checkbox"/> Jetted <input type="checkbox"/> Bored <input type="checkbox"/> Reverse rotary		
<u>Brown Clay</u>		<u>3</u>	<u>8</u>	8. Use: <input checked="" type="checkbox"/> Domestic <input type="checkbox"/> Public supply <input type="checkbox"/> Industry <input type="checkbox"/> Irrigation <input type="checkbox"/> Air conditioning <input type="checkbox"/> Stock <input type="checkbox"/> Lawn <input type="checkbox"/> Oil field water <input checked="" type="checkbox"/> Other		
<u>Fine Sand</u>		<u>8</u>	<u>10</u>	9. Casing: Material <u>PVC</u> Height <u>Above</u> below Threaded <input type="checkbox"/> Welded <input type="checkbox"/> Surface <u>18</u> in. RMP <input type="checkbox"/> PVC <input checked="" type="checkbox"/> Weight <u>2.8</u> lbs./ft. Dia. <u>5</u> in. to <u>50</u> ft. depth Wall Thickness: inches or Dia. <u>5</u> in. to <u>50</u> ft. depth gage No. <u>1265</u>		
<u>Red Shale</u>		<u>10</u>	<u>50</u>	10. Screen: Manufacturer's name <u>PVC-NSF</u> <u>200 PST</u> Type <u>PVC-200 PST</u> Dia. <u>5"</u> Slot gauze <u>0.75</u> Length <u>20'</u> Set between <u>30</u> ft. and <u>50</u> ft. Gravel pack? <u>Yes</u> ft. and <u>14-18"</u> size range of material		
				11. Static water level: <u>4</u> ft. below land surface Date <u>2-12-76</u> mo./day/yr.		
				12. Pumping level below land surfaces: ____ ft. after ____ hrs. pumping ____ g.p.m. ____ ft. after ____ hrs. pumping ____ g.p.m. Estimated maximum yield ____ g.p.m.		
				13. Water sample submitted: ____ mo./day/yr. ____ Yes ____ No Date ____		
				14. Well head completion: <u>18 Capped</u> ____ Pitless adapter ____ Inches above grade		
				15. Well grouted? <u>Yes</u> With: ____ Neat cement ____ Bentonite <input checked="" type="checkbox"/> Concrete Depth: From <u>0</u> ft. to <u>15</u> ft.		
				16. Nearest source of possible contamination: <u>None</u> ft. ____ Direction ____ Type ____ Well disinfected upon completion? <input checked="" type="checkbox"/> Yes ____ No		
				17. Pump: <input checked="" type="checkbox"/> Not installed Manufacturer's name ____ Model number ____ HP ____ Volts ____ Length of drop pipe ____ ft. capacity ____ g.p.m. Type: ____ Submersible ____ Turbine ____ Jet ____ Reciprocating ____ Centrifugal ____ Other		
		(Use a second sheet if needed)				
18. Elevation:	19. Remarks:		20. Water well contractor's certification:			
Topography: ____ Hill ____ Slope ____ Upland ____ Valley	<u>Well is to be used to wash boats down by Kinneschak yacht Club.</u>		This well was drilled under my jurisdiction and this report is true to the best of my knowledge and belief. <u>Harp Well Pump</u> <u>236</u> Business name License No. Address <u>Wichita, Kans.</u> Signed <u>M. Arnold</u> <u>2-14-76</u> Authorized representative Date			

Forward the white, blue and pink copies to the Department of Health and Environment

Form WWC-5