


1 LOCATION OF WATER WELL: Kingman	FRACTION SE 1/4 NW 1/4 SE 1/4	Section Number 4	Township Number T 27 S	Range Number R 5W E/W
---	---	----------------------------	----------------------------------	---------------------------------

Distance and direction from nearest town or city street address of well if located within city?
1450 ft. N., 1600 W. of SE corner Mount Vernon, Kansas

2 WATER WELL OWNER: ARVIN, Les RR#, ST. ADDRESS, BOX #: 125 N. Armour CITY, STATE, ZIP CODE: Wichita, Kansas 67206	Board of Agriculture, Division of Water Resource Application Number:
--	---

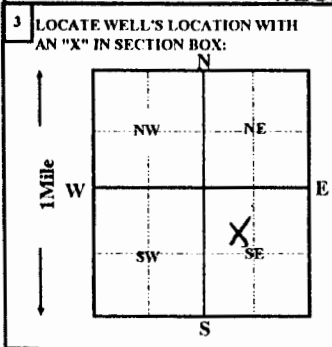

4 DEPTH OF COMPLETED WELL 62 ft. ELEVATION:	1 ft. 2 ft. 3 ft.
Depth(s) groundwater Encountered 1 ft.	
WELL'S STATIC WATER LEVEL 14.3 FT. BELOW LAND SURFACE MEASURED ON 08/17/1993	
Pump test data: Well water was _____ ft. after _____ hours pumping _____ gpm	
Est. Yield _____ gpm: Well water was _____ ft. after _____ hours pumping _____ gpm	
Bore Hole Diameter 12 in. to 62 ft., and _____ in. to _____ ft.	
WELL WATER TO BE USED AS:	
1 Domestic 3 Feedlot 6 Oil field water supply 9 Dewatering 12 Other (Specify below)	
2 Irrigation 4 Industrial 7 Lawn and garden only 10 Monitoring well	
Was a chemical/bacteriological sample submitted to Department? Yes _____ No X ; If yes, mo/day/yr sample was submitted _____	Water Well Disinfected? Yes X No _____

5 TYPE OF CASING USED:	5 Wrought iron	8 Concrete tile	CASING JOINTS:
1 Steel 3 RMP (SR)	6 Asbestos-Cement	9 Other (Specify below)	Clamped Clamped
2 PVC 4 ABS	7 Fiberglass	SDR-26	Welded Threaded SCREWS
Blank casing Diameter 5 in. to 42 ft., Dia _____ in. to _____ ft.	weight 2.35 lbs. / ft.	Wall thickness or gauge No. .214	
Casing height above land surface 12 in.,			
TYPE OF SCREEN OR PERFORATION MATERIAL:			
1 Steel 3 Stainless Steel 5 Fiberglass 8 RMP (SR) 11 other (specify)	6 Concrete tile 9 ABS 12 None used (open hole)	8 Saw cut 11 None (open hole)	
2 Brass 4 Galvanized steel		9 Drilled holes	
SCREEN OR PERFORATION OPENING ARE:	5 Gauzed wrapped	7 Torch cut	10 Other (specify)
1 Continuous slot 3 Mill slot	6 Wire wrapped		
2 Louvered shutter 4 Key punched			
SCREEN-PERFORATION INTERVALS: from 42 ft. to 62 ft., From _____ ft. to _____ ft.			
GRAVEL PACK INTERVALS: from 30 ft. to 62 ft., From _____ ft. to _____ ft.			

6 GROUT MATERIAL: 1 Neat cement	2 Cement grout	3 Bentonite	4 Other Bentonite Hole Plug
Grout Intervals: From 0 ft. to 30 ft., From _____ ft. to _____ ft.			
What is the nearest source of possible contamination:			
1 Septic tank 4 Lateral lines 7 Pit privy	8 Sewage lagoon	9 Feedyard	10 Livestock pens 11 Fuel storage 12 Fertilizer storage 13 Insecticide storage
2 Sewer lines 5 Cess pool			14 Abandon water well 15 Oil well/Gas well 16 Other (specify below)
3 Watertight sewer lines 6 Seepage pit			None Apparent
Direction from well? _____			How many feet? _____

FROM	TO	LITHOLOGIC LOG	FROM	TO	PLUGGING INTERVALS
0	3	topsoil			
3	11	clay			
11	30	fine to medium with silt			
30	31	clay			
31	44	fine sand & silt with clay			
44	44.5	clay			
44.5	52	medium sand to coarse sand			
52	54	clay			
54	62	fine to medium sand			
62		shale			

7 CONTRACTOR'S OR LANDOWNER'S CERTIFICATION: This water well was (1) constructed, (2) reconstructed, or (3) plugged under my jurisdiction and was completed on (mo/day/year) 08/17/1993 and this record is true to the best of my knowledge and belief. Kansas Water Well Contractor's License No. 236 This Water Well Record was completed on (mo/day/yr) 09/02/93 Under the business name of Harp Well & Pump Service, Inc by (signature)	<i>Jane Frederick</i>
---	-----------------------