


1 LOCATION OF WATER WELL: Kingman	FRACTION SW 1/4 NE 1/4 SE 1/4	Section Number 4	Township Number T 27 S	Range Number R 5W E/W
---	---	----------------------------	----------------------------------	---------------------------------

Distance and direction from nearest town or city street address of well if located within city?
994 ft. W, 1647 1/2 N. of SE corner Mt. Vernon, Kansas

2 WATER WELL OWNER: CITY OF GARDEN PLAIN	Board of Agriculture, Division of Water Resource
RR#, ST. ADDRESS, BOX #: ATTENTION: CITY CLERK	Application Number:
CITY, STATE, ZIP CODE: Garden Plain, KS.	

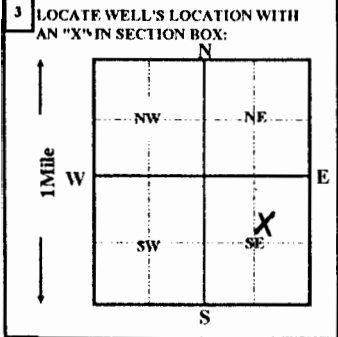

4 DEPTH OF COMPLETED WELL 62 ft. ELEVATION:	1 ft. 2 ft. 3 ft.
Depth(s) groundwater Encountered	
WELL'S STATIC WATER LEVEL 14.3 FT. BELOW LAND SURFACE MEASURED ON 08/17/1993	mo/day/yr
Pump test data:	
Well water was	ft. after hours pumping gpm
Est. Yield gpm:	Well water was ft. after hours pumping gpm
Bore Hole Diameter 12 in. to 62 ft., and in. to ft.	
WELL WATER TO BE USED AS:	
1 Domestic 3 Feedlot 6 Oil field water supply 9 Dewatering 12 Other (Specify below)	
2 Irrigation 4 Industrial 7 Lawn and garden only 10 Monitoring well TW6-93	
Was a chemical/bacteriological sample submitted to Department? Yes No <input checked="" type="checkbox"/> ; If yes, mo/day/yr sample was submitted	
Water Well Disinfected? Yes <input checked="" type="checkbox"/> No	

5 TYPE OF CASING USED:	5 Wrought iron	8 Concrete tile	CASING JOINTS: Clued Clamped
1 Steel 3 RMP (SR)	6 Asbestos-Cement	9 Other (Specify below)	Welded SCREWS
2 PVC 4 ABS	7 Fiberglass	SDR-26	Threaded
Blank casing Diameter 5 in. to 42 ft., Dia in. to ft.			
Casing height above land surface 12 in., weight 2.35 lbs. / ft.			Wall thickness or gauge No. .214
TYPE OF SCREEN OR PERFORATION MATERIAL:			
1 Steel 3 Stainless Steel 5 Fiberglass 8 RMP (SR)			10 Asbestos-cement 11 other (specify)
2 Brass 4 Galvanized steel 6 Concrete tile 9 ABS			12 None used (open hole)
SCREEN OR PERFORATION OPENING ARE:			
1 Continuous slot 3 Mill slot 5 Gauzed wrapped 8 Saw cut 11 None (open hole)			
2 Louvered shutter 4 Key punched 6 Wire wrapped 9 Drilled holes			
	7 Torch cut		10 Other (specify)
SCREEN-PERFORATION INTERVALS: from 42 ft. to 62 ft., From ft. to ft.			
GRAVEL PACK INTERVALS: from 30 ft. to 62 ft., From ft. to ft.			

6 GROUT MATERIAL: 1 Neat cement	2 Cement grout	3 Bentonite	4 Other Bentonite hole plug
Grout Intervals: From ft. to ft., From ft. to ft., From ft. to ft.			
What is the nearest source of possible contamination:			
1 Septic tank 4 Lateral lines 7 Pit privy 10 Livestock pens 14 Abandon water well			
2 Sewer lines 5 Cess pool 8 Sewage lagoon 11 Fuel storage 15 Oil well/Gas well			
3 Watertight sewer lines 6 Seepage pit 9 Feedyard 12 Fertilizer storage 16 Other (specify below)			
			None Apparent
Direction from well?			How many feet?

FROM	TO	LITHOLOGIC LOG	FROM	TO	PLUGGING INTERVALS
0	3	topsoil			
3	11	clay			
11	30	fine to medium with silt			
30	31	clay			
31	44	fine sand & silt with clay			
44	44.5	clay			
44.5	52	medium sand to coarse sand			
52	54	clay			
54	62	fine to medium sand			
62		shale			

7 CONTRACTOR'S OR LANDOWNER'S CERTIFICATION: This water well was (1) constructed, (2) reconstructed, or (3) plugged under my jurisdiction and was completed on (mo/day/year) **08/17/1993** and this record is true to the best of my knowledge and belief. Kansas Water Well Contractor's License No. **236** This Water Well Record was completed on (mo/day/yr) **09/02/93**

Under the business name of **Harp Well & Pump Service, Inc** by (signature) *Jane Frederick*

633