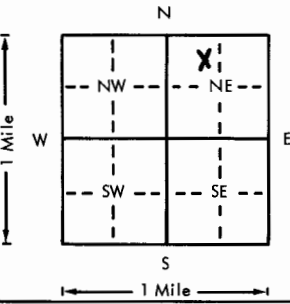


USE TYPEWRITER OR BALL POINT PEN-PRESS FIRMLY, PRINT CLEARLY.

WATER WELL RECORD
KSA 82a-1201-1215

Kansas Department of Health and Environment-Division of Environment
(Water well Contractors)
Topeka, Kansas 66620

Billed to: **Twenty-First Electric**

1. Location of well:		County Kingman	Fraction 1/4 Nw 1/4 Ne 1/4	Section number 11	Township number T 27 S R 5	Range number 5
2. Distance and direction from nearest town or city: Street address of well location if in city: 3/4 East of Mt. Vernon on 21st Street No. and 1/8 mile South. Mt. Vernon, Kansas				3. Owner of well: Mr. Charles Lefiven R. R. #2 Cheney, Kansas City, state, zip code:		
4. Locate with "X" in section below: 				6. Bore hole dia. 11 in. Completion date 12-13-76 Well depth 70 ft.		
5. Type and color of material				7. <input checked="" type="checkbox"/> Cable tool <input checked="" type="checkbox"/> Rotary <input type="checkbox"/> Driven <input type="checkbox"/> Dug <input type="checkbox"/> Hollow rod <input type="checkbox"/> Jetted <input type="checkbox"/> Bored <input type="checkbox"/> Reverse rotary		
				8. Use: <input checked="" type="checkbox"/> Domestic <input type="checkbox"/> Public supply <input type="checkbox"/> Industry <input type="checkbox"/> Irrigation <input type="checkbox"/> Air conditioning <input type="checkbox"/> Stock <input type="checkbox"/> Lawn <input type="checkbox"/> Oil field water <input type="checkbox"/> Other		
From To				9. Casing: Material styrene Height: Above or below Threaded <input type="checkbox"/> Welded <input checked="" type="checkbox"/> Surface 12 in. RMP <input checked="" type="checkbox"/> PVC <input type="checkbox"/> Weight _____ lbs./ft. Dia. 5 in. to 70 ft. depth Wall Thickness: inches or Dia. _____ in. to _____ ft. depth gage No. 200		
				10. Screen: Manufacturer's name Sunflower Plastic Type styrene Dia. 5" Slot/gauge 20.06 Length 50' Set between 20 ft. and 70 ft. Gravel pack? yes Size range of material 1-1/8"		
Sandy Topsoil				0	2	11. Static water level: _____ mo./day/yr. 21 ft. below land surface Date 12-13-76
Clay				2	12	12. Pumping level below land surfaces: _____ ft. after _____ hrs. pumping _____ g.p.m. _____ ft. after _____ hrs. pumping _____ g.p.m. Estimated maximum yield _____ g.p.m.
Medium Sand				12	28	13. Water sample submitted: _____ mo./day/yr. Yes <input type="checkbox"/> No <input type="checkbox"/> Date _____
Red Shale				28	70	14. Well head completion: _____ <input checked="" type="checkbox"/> Pitless adapter 12 inches above grade
(Use a second sheet if needed)						15. Well grouted? yes With: <input type="checkbox"/> Neat cement <input type="checkbox"/> Bentonite <input checked="" type="checkbox"/> Concrete Depth: From 40" ft. to 14 ft.
						16. Nearest source of possible contamination: Septic ft. 60 Direction SE Type tank Well disinfected upon completion? <input checked="" type="checkbox"/> Yes <input type="checkbox"/> No
						17. Pump: <input checked="" type="checkbox"/> Not installed Manufacturer's name _____ Model number _____ HP _____ Volts _____ Length of drop pipe _____ ft. capacity _____ g.p.m. Type: <input type="checkbox"/> Submersible <input type="checkbox"/> Turbine <input type="checkbox"/> Jet <input type="checkbox"/> Reciprocating <input type="checkbox"/> Centrifugal <input type="checkbox"/> Other
18. Elevation:		19. Remarks:		20. Water well contractor's certification: This well was drilled under my jurisdiction and this report is true to the best of my knowledge and belief. Harp Well & Pump 236 Business name _____ License No. 67209 Address Wichita, Kansas Signed McDonald Date 12-20-76 Authorized representative		
Topography: <input type="checkbox"/> Hill <input checked="" type="checkbox"/> Slope <input type="checkbox"/> Upland <input type="checkbox"/> Valley						

27-50-11
 T
 R
 Sec
 1/4
 NE

Forward the white, blue and pink copies to the Department of Health and Environment

Form WWC-5