WATER WELL RECORD Form WWC-5 KSA 82a-1212

1 LOCATION OF WATER WELL: County: Kingman | Fraction: NE ¼ NW ¼ NE ¼ | Section Number: 11 | Township Number: T 27 S | Range Number: R 5 E (W)

Distance and direction from nearest town or city street address of well if located within city?
¾ E. Mt. Vernon

2 WATER WELL OWNER: Mrs. Daren Davis
RR#, St. Address, Box # : RR
City, State, ZIP Code : Cheney, Ks. 67025
Board of Agriculture, Division of Water Resources
Application Number:

3 LOCATE WELL'S LOCATION WITH AN "X" IN SECTION BOX:

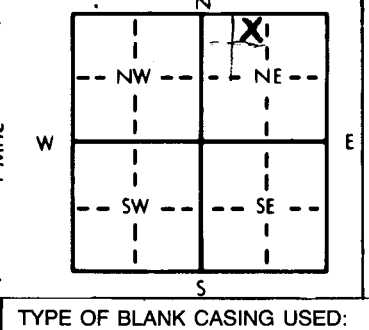

4 DEPTH OF COMPLETED WELL 91 ft. ELEVATION:
Depth(s) Groundwater Encountered 1. 36 ft. 2. 62 ft. 3. 82 ft.
WELL'S STATIC WATER LEVEL 35 ft. below land surface measured on mo/day/yr 5-13-86
Pump test data: Well water was ... ft. after ... hours pumping ... gpm
Est. Yield ... gpm: Well water was ... ft. after ... hours pumping ... gpm
Bore Hole Diameter 11 in. to 91 ft., and ... in. to ... ft.
WELL WATER TO BE USED AS: 1 Domestic 2 Irrigation 3 Feedlot 4 Industrial 5 Public water supply 6 Oil field water supply (7 Lawn and garden only) 8 Air conditioning 9 Dewatering 10 Observation well 11 Injection well 12 Other (Specify below)
Was a chemical/bacteriological sample submitted to Department? Yes (No); If yes, mo/day/yr sample was submitted
Water Well Disinfected? (Yes) No

5 TYPE OF BLANK CASING USED: 1 Steel (3 RMP (SR)) 2 PVC 4 ABS 5 Wrought iron 6 Asbestos-Cement 7 Fiberglass 8 Concrete tile 9 Other (specify below)
CASING JOINTS: (Glued) Clamped Welded Threaded
Blank casing diameter 6 in. to 57 ft., Dia ... in. to ... ft., Dia ... in. to ... ft.
Casing height above land surface 18 in., weight ... lbs./ft. Wall thickness or gauge No. SDR 26

TYPE OF SCREEN OR PERFORATION MATERIAL: 1 Steel 2 Brass 3 Stainless steel 4 Galvanized steel 5 Fiberglass 6 Concrete tile 7 PVC (8 RMP (SR)) 9 ABS 10 Asbestos-cement 11 Other (specify) 12 None used (open hole)
SCREEN OR PERFORATION OPENINGS ARE: 1 Continuous slot 2 Louvered shutter 3 Mill slot 4 Key punched 5 Gauzed wrapped 6 Wire wrapped 7 Torch cut (8 Saw cut) 9 Drilled holes 10 Other (specify) 11 None (open hole)
SCREEN-PERFORATED INTERVALS: From 51 ft. to 91 ft., From ... ft. to ... ft.
From ... ft. to ... ft., From ... ft. to ... ft.
GRAVEL PACK INTERVALS: From 14 ft. to 91 ft., From ... ft. to ... ft.
From ... ft. to ... ft., From ... ft. to ... ft.

6 GROUT MATERIAL: 1 Neat cement 2 Cement grout (3 Bentonite) 4 Other
Grout Intervals: From 3 ft. to 14 ft., From ... ft. to ... ft., From ... ft. to ... ft.
What is the nearest source of possible contamination: (1 Septic tank) 2 Sewer lines 3 Watertight sewer lines 4 Lateral lines 5 Cess pool 6 Seepage pit 7 Pit privy 8 Sewage lagoon 9 Feedyard 10 Livestock pens 11 Fuel storage 12 Fertilizer storage 13 Insecticide storage 14 Abandoned water well 15 Oil well/Gas well 16 Other (specify below)
Direction from well? S.W. How many feet? 175

FROM	TO	LITHOLOGIC LOG	FROM	TO	LITHOLOGIC LOG
0	4	Soil			
4	38	Sand & clay			
38	91	Shale			

7 CONTRACTOR'S OR LANDOWNER'S CERTIFICATION: This water well was (1) (constructed), (2) reconstructed, or (3) plugged under my jurisdiction and was completed on (mo/day/year) 5-13-86 and this record is true to the best of my knowledge and belief. Kansas Water Well Contractor's License No. 395 This Water Well Record was completed on (mo/day/yr) 6-11-86
under the business name of Craig Roberts Co. by (signature) Craig Roberts

INSTRUCTIONS: Use typewriter or ball point pen, *PLEASE PRESS FIRMLY* and *PRINT* clearly. Please fill in blanks, underline or circle the correct answers. Send top three copies to Kansas Department of Health and Environment, Division of Environment, Environmental Geology Section, Topeka, KS 66620. Send one to WATER WELL OWNER and retain one for your records.

OFFICE USE ONLY