


WATER WELL RECORD Form WWC-5 KSA 82a-1212

1 LOCATION OF WATER WELL: Kingman	FRACTION SE 1/4 NE 1/4 NE 1/4	SECTION NUMBER 11	TOWNSHIP NUMBER T 27 S	RANGE NUMBER R 5W E/W
---	---	-----------------------------	----------------------------------	---------------------------------

Distance and direction from nearest town or city street address of well if located within city?
15903 N.E. Countryside Cheney, Kansas

2 WATER WELL OWNER: LIFESTYLE HOMES	RR#,ST. ADDRESS,BOX #: 1354 S. Ridge Road	Board of Agriculture, Division of Water Resource
CITY, STATE: Wichita, Kansas	ZIP CODE:	Application Number:

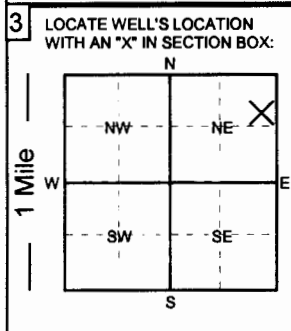

4 DEPTH OF COMPLETED WELL: 80 ft.	ELEVATION:
Depth of groundwater Encountered: _____ ft. _____ ft.	
WELL'S STATIC WATER LEVEL 20 FT. BELOW LAND SURFACE MEASURED ON 7/24/12	
Pump test data:	Well water was _____ ft. after _____ hours of pumping @ _____ gpm
Est. Yield:	Well water was _____ ft. after _____ hours of pumping @ _____ gpm
Bore Hole Diameter 12 in.	to 80 ft. and _____ in. to _____ ft.
WELL WATER TO BE USED AS:	
<input checked="" type="checkbox"/> 1. Domestic <input type="checkbox"/> 3. Feedlot <input type="checkbox"/> 5. Public water supply <input type="checkbox"/> 7. Lawn and garden only <input type="checkbox"/> 9. Dewatering <input type="checkbox"/> 11. Injection well <input type="checkbox"/> 2. Irrigation <input type="checkbox"/> 4. Industrial <input type="checkbox"/> 6. Oil field water supply <input type="checkbox"/> 8. Air conditioning <input type="checkbox"/> 10. Monitoring well <input type="checkbox"/> 12. Other (Specify below)	
Was a chemical/bacteriological sample submitted to Department? YES <input checked="" type="checkbox"/> NO <input type="checkbox"/> ; If yes, what mo/day/yr was sample submitted	
Was Water Well Disinfected? <input checked="" type="checkbox"/> YES <input type="checkbox"/> NO	

5 TYPE OF CASING USED:		5. Wrought Iron	7. Fiberglass	9. Other (Specify below)	CASING JOINTS:	<input checked="" type="checkbox"/> Glued	<input type="checkbox"/> Threaded
<input type="checkbox"/> 1. Steel <input type="checkbox"/> 3. RPM (SR) <input checked="" type="checkbox"/> 2. PVC <input type="checkbox"/> 4. ABS <input type="checkbox"/> 6. Asbestos-Cement <input type="checkbox"/> 8. Concrete tile		SDR-26		Welded		Clamped	
Blank casing diameter 5 in.		to 31 ft.,	Dia.	in.	to _____ ft.,	Dia.	in.
Casing height above land surface: 12 in.,		Weight:	2.35 lbs. / ft.	Wall thickness or gauge No.	.214		
TYPE OF SCREEN OR PERFORATION MATERIAL:							
<input type="checkbox"/> 1. Steel <input type="checkbox"/> 3. Stainless Steel <input type="checkbox"/> 5. Fiberglass <input checked="" type="checkbox"/> 7. PVC <input type="checkbox"/> 9. ABS <input type="checkbox"/> 11. Other (specify) <input type="checkbox"/> 2. Brass <input type="checkbox"/> 4. Galvanized <input type="checkbox"/> 6. Concrete Tile <input type="checkbox"/> 8. RMP (SR) <input type="checkbox"/> 10. Asbestos-Cement <input type="checkbox"/> 12. None used (open hole)							
SCREEN OR PERFORATION OPENINGS ARE:							
<input type="checkbox"/> 1. Continuous slot <input type="checkbox"/> 3. Mill slot <input type="checkbox"/> 5. Gauzed wrapped <input type="checkbox"/> 7. Torch cut <input type="checkbox"/> 9. Drilled holes <input type="checkbox"/> 11. None (open hole) <input type="checkbox"/> 2. Louvered shutter <input type="checkbox"/> 4. Key punched <input type="checkbox"/> 6. Wire wrapped <input checked="" type="checkbox"/> 8. Saw cut <input type="checkbox"/> 10. Other (specify)							
SCREEN - PERFORATION INTERVAL							
From 31 ft.		to 80 ft.,	From _____ ft.	to _____ ft.	From _____ ft.	to _____ ft.	From _____ ft.
GRAVEL PACK INTERVALS:		From 24 ft.	to 80 ft.,	From _____ ft.	to _____ ft.	From _____ ft.	to _____ ft.

6 GROUT MATERIALS:		1. Neat cement	2. Cement Grout	3. Bentonite	Other bentonite hole plug
Grout Intervals: From 4 ft.		to 24 ft.,	From _____ ft.	to _____ ft.,	From _____ ft.
What is the nearest source of possible contamination:					
<input type="checkbox"/> 1. Septic tank <input type="checkbox"/> 4. Lateral lines <input type="checkbox"/> 7. Pit privy <input type="checkbox"/> 10. Livestock pens <input type="checkbox"/> 13. Insecticide storage <input type="checkbox"/> 15. Oil well/Gas well <input type="checkbox"/> 2. Sewer lines <input type="checkbox"/> 5. Cess Pool <input type="checkbox"/> 8. Sewage lagoon <input type="checkbox"/> 11. Fuel storage <input type="checkbox"/> 14. Abandon water well <input type="checkbox"/> 16. Other (specify below) <input type="checkbox"/> 3. Watertight sewer line <input type="checkbox"/> 6. Seepage pit <input type="checkbox"/> 9. Feed yard <input type="checkbox"/> 12. Fertilizer storage <input type="checkbox"/> None Yet					
Direction from well? _____ How many feet? _____					

From	To	LITHOLOGIC LOG	From	To	LITHOLOGIC LOG
0	3	topsoil			
3	10	clay			
10	20	fine sand			
20	35	medium sand			
35	80	grey shale			

7 Contractor's or Landowner's Certification: This water well was 1. <input checked="" type="checkbox"/> constructed 2. <input type="checkbox"/> reconstructed or 3. <input type="checkbox"/> plugged under my jurisdiction and was completed on (mo/day/year) 7/24/2012 and this record is true to the best of my knowledge and belief.	
Kansas Water Well Contractor's License No. 236	This water well record was completed on (mo/day/year) 8/3/2012
under the business name of Harp Well and Pump Service	by (signature) Todd S. Harp