


1 LOCATION OF WATER WELL: Kingman	FRACTION SW 1/4 NE 1/4 SE 1/4	Section Number 4	Township Number T 27 S	Range Number R 5W E/W
---	---	----------------------------	----------------------------------	---------------------------------

Distance and direction from nearest town or city street address of well if located within city?

1 mile West- 5/16 mile N. & 1000' W. of Mt. Vernon, Kansas

2 WATER WELL OWNER: CITY OF GARDEN PLAIN	Board of Agriculture, Division of Water Resource	Application Number: 38,900
RR#, ST. ADDRESS, BOX #: City Hall Box 336	CITY, STATE, ZIP CODE: Garden Plain, Kansas 67050	

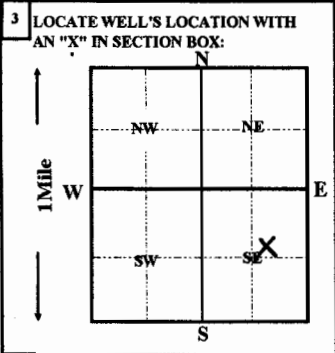

4 DEPTH OF COMPLETED WELL 62 ft.	ELEVATION: ground level	
Depth(s) groundwater Encountered 1 ft. 2 ft. 3 ft.		
WELL'S STATIC WATER LEVEL 14.3 FT. BELOW LAND SURFACE MEASURED ON 11/18/1994		
Pump test data:	Well water was	ft. after hours pumping gpm
Est. Yield	gpm: Well water was	ft. after hours pumping gpm
Bore Hole Diameter 30 in. to 62	ft. and in. to	ft.
WELL WATER TO BE USED AS:	5 Public water supply	8 Air conditioning 11 Injection well
1 Domestic 3 Feedlot 6 Oil field water supply 9 Dewatering 12 Other (Specify below)	2 Irrigation 4 Industrial 7 Lawn and garden only 10 Monitoring well	
Was a chemical/bacteriological sample submitted to Department? Yes	No <input checked="" type="checkbox"/> ; If yes, mo/day/yr sample was submitted	
Water Well Disinfected? Yes <input checked="" type="checkbox"/> No		

5 TYPE OF CASING USED:	5 Wrought iron	8 Concrete tile	CASING JOINTS: Glued Clamped
1 Steel 3 RMP (SR)	6 Asbestos-Cement	9 Other (Specify below)	Welded <input checked="" type="checkbox"/>
2 PVC 4 ABS	7 Fiberglass		Threaded
Blank casing Diameter 12 in. to 42 ft., Dia	in. to	ft., Dia	in. to
Casing height above land surface 2.5 ft. in., weight 49.56 lbs. / ft.		Wall thickness or gauge No. .375	
TYPE OF SCREEN OR PERFORATION MATERIAL:	5 Fiberglass	8 RMP (SR)	11 other (specify)
1 Steel 3 Stainless Steel	6 Concrete tile	9 ABS	12 None used (open hole)
2 Brass 4 Galvanized steel			
SCREEN OR PERFORATION OPENING ARE:	5 Gauzed wrapped	8 Saw cut	11 None (open hole)
1 Continuous slot 3 Mill slot	6 Wire wrapped	9 Drilled holes	
2 Louvered shutter 4 Key punched	7 Torch cut	10 Other (specify)	
SCREEN-PERFORATION INTERVALS:	from 42 ft. to 62	ft., From	ft. to
	ft. to	ft., From	ft. to
GRAVEL PACK INTERVALS:	from 32 ft. to 62	ft., From	ft. to
	ft. to	ft., From	ft. to

6 GROUT MATERIAL: 1 Neat cement	2 Cement grout	3 Bentonite	4 Other 50-50 road sand & bentonite hole plug
Grout Intervals: From 1 ft. to 24	ft. From (other) 24	ft. to 32	ft. From ft. to
What is the nearest source of possible contamination:	10 Livestock pens	14 Abandon water well	
1 Septic tank 4 Lateral lines 7 Pit privy	11 Fuel storage	15 Oil well/Gas well	
2 Sewer lines 5 Cess pool 8 Sewage lagoon	12 Fertilizer storage	16 Other (specify below)	
3 Watertight sewer lines 6 Seepage pit 9 Feedyard	13 Insecticide storage	None Apparent	
Direction from well?	How many feet?		

FROM	TO	LITHOLOGIC LOG	FROM	TO	PLUGGING INTERVALS
0	2	sandy soil			
2	10	tan clay			
10	20	fine to coarse sand & fine to medium gravel with silt			
20	28	fine to coarse sand & fine to coarse gravel (loose)			
28	34	fine to coarse sand & fine to coarse gravel			
34	45	very fine to coarse sand and some silt			
45	51	fine to coarse sand & fine to coarse gravel			
51	54	white clay			
54	62	very fine to fine sand			
62	63	red shale			

7 CONTRACTOR'S OR LANDOWNER'S CERTIFICATION: This water well was (1) constructed, (2) reconstructed, or (3) plugged under my jurisdiction and was completed on (mo/day/year) 11/18/1994 and this record is true to the best of my knowledge and belief. Kansas Water Well Contractor's License No. 236 This Water Well Record was completed on (mo/day/yr) 12/08/94	
Under the business name of Harp Well & Pump Service, Inc by (signature)	<i>Jane Frederick</i>