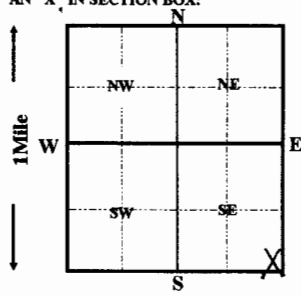


1 LOCATION OF WATER WELL: Kingman	FRACTION SE 1/4 SE 1/4 SE 1/4	Section Number 26	Township Number T 27 S	Range Number R 5W E/W
---	---	-----------------------------	----------------------------------	---------------------------------

Distance and direction from nearest town or city street address of well if located within city?
Mt. Vernon Rd. & Old 54, 1/4 S., 1/8 West, N. side Cheney, KS.

2 WATER WELL OWNER: GRACEY, Rodger RR#, ST. ADDRESS, BOX #: 1910 S. Apache CITY, STATE, ZIP CODE: Cheney, Kansas	Board of Agriculture, Division of Water Resource Application Number:
---	---

3 LOCATE WELL'S LOCATION WITH AN "X" IN SECTION BOX: 	4 DEPTH OF COMPLETED WELL 80 ft. ELEVATION: Depth(s) groundwater Encountered 1 ft. 2 ft. 3 ft. WELL'S STATIC WATER LEVEL 17 FT. BELOW LAND SURFACE MEASURED ON mo/day/yr 12/19/1994 Pump test data: Well water was _____ ft. after _____ hours pumping _____ gpm Est. Yield gpm: Well water was _____ ft. after _____ hours pumping _____ gpm Bore Hole Diameter 12 in. to 80 ft. and _____ in. to _____ ft. WELL WATER TO BE USED AS: 1 Domestic 3 Feedlot 6 Oil field water supply 9 Dewatering 12 Other (Specify below) 2 Irrigation 4 Industrial 7 Lawn and garden only 10 Monitoring well Was a chemical/bacteriological sample submitted to Department? Yes _____ No X ; If yes, mo/day/yr sample was submitted _____ Water Well Disinfected? Yes X No _____
--	--

5 TYPE OF CASING USED: 1 Steel 3 RMP (SR) 2 PVC 4 ABS Blank casing Diameter 5 in. to 25 ft., Dia _____ in. to _____ ft. Casing height above land surface 12 in., weight 2.35 lbs. / ft. Wall thickness or gauge No. .214 TYPE OF SCREEN OR PERFORATION MATERIAL: 1 Steel 3 Stainless Steel 5 Fiberglass 8 RMP (SR) 11 other (specify) 2 Brass 4 Galvanized steel 6 Concrete tile 9 ABS 12 None used (open hole) SCREEN OR PERFORATION OPENING ARE: 1 Continous slot 3 Mill slot 5 Gauzed wrapped 8 Saw cut 11 None (open hole) 2 Louvered shutter 4 Key punched 6 Wire wrapped 9 Drilled holes 7 Torch cut 10 Other (specify)	CASING JOINTS: Glued X Clamped Welded Threaded SDR-26
SCREEN-PERFORATION INTERVALS: from 25 ft. to 80 ft., From _____ ft. to _____ ft. GRAVEL PACK INTERVALS: from 24 ft. to 80 ft., From _____ ft. to _____ ft.	

6 GROUT MATERIAL: 1 Neat cement	2 Cement grout	3 Bentonite	4 Other
Grout Intervals: From 4 ft. to 24 ft. From _____ ft. to _____ ft.			
What is the nearest source of possible contamination: 1 Septic tank 4 Lateral lines 7 Pit privy 2 Sewer lines 5 Cess pool 8 Sewage lagoon 3 Watertight sewer lines 6 Seepage pit 9 Feedyard		10 Livestock pens 14 Abandon water well 11 Fuel storage 15 Oil well/Gas well 12 Fertilizer storage 16 Other (specify below) 13 Insecticide storage None Apparent	
Direction from well?		How many feet?	

FROM	TO	LITHOLOGIC LOG	FROM	TO	PLUGGING INTERVALS
0	3	topsoil			
3	16	clay			SEPTIC SYSTEM NOT INSTALLED AT THIS TIME
16	80	red shale			

7 CONTRACTOR'S OR LANDOWNER'S CERTIFICATION: This water well was (1) constructed, (2) reconstructed, or (3) plugged under my jurisdiction and was completed on (mo/day/year) **12/19/1994** and this record is true to the best of my knowledge and belief. Kansas Water Well Contractor's License No. **236** This Water Well Record was completed on (mo/day/yr) **12/20/94**
 Under the business name of **Harp Well & Pump Service, Inc.** by (signature) *Jane Frederick*