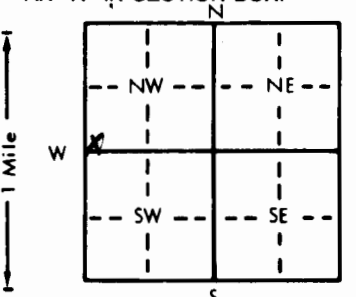


1 LOCATION OF WATER WELL: County: Kingman Fraction: SW 1/4 SW 1/4 NW 1/4 Section Number: 13 Township Number: T 27 S Range Number: R 6 **(EW)**

Distance and direction from nearest town or city street address of well if located within city?
6 mi. W, 1/2 S of MT Vernon

2 WATER WELL OWNER: Ervin Schrag
 RR#, St. Address, Box #: Rt 2
 City, State, ZIP Code: Pretty Prairie, KS 67570
 Board of Agriculture, Division of Water Resources
 Application Number:

3 LOCATE WELL'S LOCATION WITH AN "X" IN SECTION BOX:

 4 DEPTH OF COMPLETED WELL: 38 ft. ELEVATION:
 Depth(s) Groundwater Encountered 1. ft. 2. ft. 3. ft.
 WELL'S STATIC WATER LEVEL: 5 ft. below land surface measured on 4-16-84
 Pump test data: Well water was 8 ft. after 1 hours pumping 20 gpm
 Est. Yield 40 gpm: Well water was ft. after hours pumping gpm
 Bore Hole Diameter: 10 in. to 38 ft., and in. to ft.
 WELL WATER TO BE USED AS:
 Domestic 3 Feedlot 6 Oil field water supply 9 Dewatering 12 Other (Specify below)
 Irrigation 4 Industrial 7 Lawn and garden only 10 Observation well
 Was a chemical/bacteriological sample submitted to Department? Yes.....No X.....; If yes, mo/day/yr sample was submitted
 Water Well Disinfected? Yes X No

5 TYPE OF BLANK CASING USED:
 1 Steel 3 RMP (SR) 5 Wrought iron 8 Concrete tile CASING JOINTS: Glued X Clamped
 PVC 4 ABS 7 Fiberglass 9 Other (specify below) Welded
 Blank casing diameter: 6 in. to 20 ft., Dia. 6 in. to 38 ft., Dia. in. to ft.
 Casing height above land surface: 12 in., weight 3.25 lbs./ft. Wall thickness or gauge No. 160
 TYPE OF SCREEN OR PERFORATION MATERIAL:
 1 Steel 3 Stainless steel 5 Fiberglass 8 RMP (SR) 10 Asbestos-cement
 2 Brass 4 Galvanized steel 6 Concrete tile 9 ABS 11 Other (specify)
 12 None used (open hole)
 SCREEN OR PERFORATION OPENINGS ARE:
 1 Continuous slot 3 Mill slot 5 Gauzed wrapped 8 Saw cut 11 None (open hole)
 2 Louvered shutter 4 Key punched 6 Wire wrapped 9 Drilled holes
 7 Torch cut 10 Other (specify)
 SCREEN-PERFORATED INTERVALS: From 20 ft. to 30 ft., From ft. to ft.
 From ft. to ft., From ft. to ft.
 GRAVEL PACK INTERVALS: From 03 ft. to 38 ft., From ft. to ft.
 From ft. to ft., From ft. to ft.

6 GROUT MATERIAL: Neat cement 2 Cement grout 3 Bentonite 4 Other
 Grout Intervals: From 3 ft. to 13 ft., From ft. to ft., From ft. to ft.
 What is the nearest source of possible contamination:
 Septic tank 4 Lateral lines 7 Pit privy 10 Livestock pens 14 Abandoned water well
 2 Sewer lines 5 Cess pool 8 Sewage lagoon 11 Fuel storage 15 Oil well/Gas well
 3 Watertight sewer lines 6 Seepage pit 9 Feedyard 12 Fertilizer storage 16 Other (specify below)
 13 Insecticide storage
 Direction from well? S How many feet? 140

FROM	TO	LITHOLOGIC LOG	FROM	TO	LITHOLOGIC LOG
0	1	Sandy Top Soil			
1	11	Br Clay			
11	28	S+G			
28	38	Red Clay			

7 CONTRACTOR'S OR LANDOWNER'S CERTIFICATION: This water well was constructed, (2) reconstructed, or (3) plugged under my jurisdiction and was completed on (mo/day/year) 4-19-84 and this record is true to the best of my knowledge and belief. Kansas Water Well Contractor's License No. 447 This Water Well Record was completed on (mo/day/yr) 5-28-84 under the business name of Miller Drilling by (signature) Eva Mills
 INSTRUCTIONS: Use typewriter or ball point pen, PLEASE PRESS FIRMLY and PRINT clearly. Please fill in blanks, underline or circle the correct answers. Send top three copies to Kansas Department of Health and Environment, Division of Environment, Environmental Geology Section, Topeka, KS 66620. Send one to WATER WELL OWNER and retain one for your records.