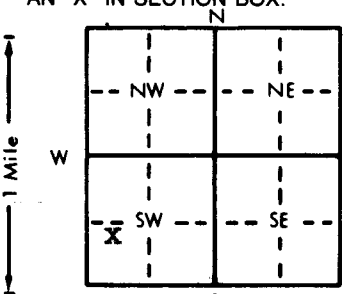


1 LOCATION OF WATER WELL: County: Kingman Fraction: NW SW SW Section Number: 33 Township Number: T 27 S Range Number: R 6 **EAW**

Distance and direction from nearest town or city street address of well if located within city?
3 W 1 S Midway

2 WATER WELL OWNER: Mrs Ray Hubbell
 RR#, St. Address, Box # : R 2 Board of Agriculture, Division of Water Resources
 City, State, ZIP Code : Kingman, Ks. 67068 Application Number:

3 LOCATE WELL'S LOCATION WITH AN "X" IN SECTION BOX:  DEPTH OF COMPLETED WELL: 137 ~~121~~ ft. ELEVATION: 15 ft.
 WELL'S STATIC WATER LEVEL 20 ft. below land surface measured on mo/day/yr 9-23-89
 Bore Hole Diameter 8 in. to 137 ft., and 8 in. to 137 ft.
 WELL WATER TO BE USED AS:
 1 Domestic 1 3 Feedlot 3 6 Oil field water supply 6 9 Dewatering 9 12 Other (Specify below)
 2 Irrigation 2 4 Industrial 4 7 Lawn and garden only 7 10 Monitoring well 10
 Was a chemical/bacteriological sample submitted to Department? Yes No; If yes, mo/day/yr sample was submitted
 Water Well Disinfected? Yes Yes No No

5 TYPE OF BLANK CASING USED:
 1 Steel 2 PVC 3 RMP (SR) 4 ABS 5 Wrought iron 6 Asbestos-Cement 7 Fiberglass 8 Concrete tile 9 Other (specify below) CASING JOINTS: Glued Clamped Welded Threaded
 Blank casing diameter 5 in. to 19 ft., Dia 5 in. to 19 ft., Dia 5 in. to 19 ft.
 Casing height above land surface 15 in., weight lbs./ft. Wall thickness or gauge No. 214
 TYPE OF SCREEN OR PERFORATION MATERIAL:
 1 Steel 2 Brass 3 Stainless steel 4 Galvanized steel 5 Fiberglass 6 Concrete tile 7 PVC 7 PVC 8 RMP (SR) 9 ABS 10 Asbestos-cement 11 Other (specify) 12 None used (open hole)
 SCREEN OR PERFORATION OPENINGS ARE:
 1 Continuous slot 2 Louvered shutter 3 Mill slot 4 Key punched 5 Gauzed wrapped 6 Wire wrapped 7 Torch cut 8 Saw cut 8 Saw cut 9 Drilled holes 11 None (open hole)

 What is the nearest source of possible contamination:
 1 Septic tank 1 2 Sewer lines 2 3 Watertight sewer lines 3 4 Lateral lines 5 Cess pool 6 Seepage pit 7 Pit privy 8 Sewage lagoon 9 Feedyard 10 Livestock pens 11 Fuel storage 12 Fertilizer storage 13 Insecticide storage 600 14 Abandoned water well 15 Oil well/Gas well 16 Other (specify below)
 Direction from well? W How many feet? 600

FROM	TO	LITHOLOGIC LOG	FROM	TO	PLUGGING INTERVALS
0	3	Soil			
3	6	clay			
6	24	med sans			
24	137	red shale			

7 CONTRACTOR'S OR LANDOWNER'S CERTIFICATION: This water well was (1) constructed, (2) reconstructed, or (3) plugged under my jurisdiction and was completed on (mo/day/year) 9-23-89 and this record is true to the best of my knowledge and belief. Kansas Water Well Contractor's License No. 140 This Water Well Record was completed on (mo/day/yr) 9-23-89 under the business name of Lyman, inc. by (signature)

INSTRUCTIONS: Use typewriter or ball point pen. PLEASE PRESS FIRMLY and PRINT clearly. Please fill in blanks, underline or circle the correct answers. Send top three copies to Kansas Department of Health and Environment, Bureau of Water Protection, Topeka, Kansas 66620-7320. Telephone: 913-296-5514. Send one to WATER WELL OWNER and retain one for your records.