

1 LOCATION OF WATER WELL:	Fraction	Section Number	Township Number	Range Number
County: <u>Kingman</u>	<u>SW 1/4 SW 1/4</u>	<u>25</u>	T <u>27</u> S	R <u>6</u> EW


Distance and direction from nearest town or city street address of well if located within city?

1/2 mile S of Hwy 101 East side of Road

2 WATER WELL OWNER: Ted J. Sheer, Jr.
 RR#, St. Address, Box #: 10074 NE 10th Street
 City, State, ZIP Code: MURDOCK, KS 67111

Board of Agriculture, Division of Water Resources
Application Number:3 LOCATE WELL'S LOCATION WITH 4 DEPTH OF COMPLETED WELL 50 ft. ELEVATION: 6-16-06

AN "X" IN SECTION BOX:

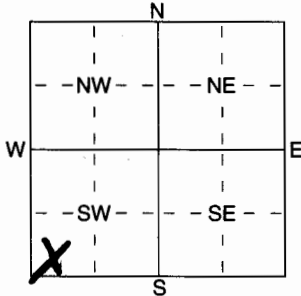

Depth(s) Groundwater Encountered 14 ft. 2 16-06 ft. 3 16-06 ft.
 WELL'S STATIC WATER LEVEL 14 ft. below land surface measured on mo/day/yr 6-16-06

Pump test data: Well water was 14 ft. after 16 hours pumping 16 gpm
 Est. Yield 14 gpm: Well water was 14 ft. after 16 hours pumping 16 gpm

WELL WATER TO BE USED AS: 5 Public water supply 8 Air conditioning 11 Injection well
X 1 Domestic 3 Feedlot 6 Oil field water supply 9 Dewatering 12 Other (Specify below)
 2 Irrigation 4 Industrial 7 Domestic (lawn & garden) 10 Monitoring well

Was a chemical/bacteriological sample submitted to Department? Yes X No X; If yes, mo/day/yr sample was submitted
 Water Well Disinfected? Yes X No

5 TYPE OF BLANK CASING USED: 5 Wrought iron 8 Concrete tile CASING JOINTS: Glued X Clamped

X 1 Steel 3 RMP (SR) 6 Asbestos-Cement 9 Other (specify below) Welded
X 2 PVC 4 ABS 7 Fiberglass Threaded

Blank casing diameter 5 in. to 50 ft., Dia 160 in. to 160 ft., DiaCasing height above land surface 12 in., weight 160 lbs./ft. Wall thickness or gauge No.TYPE OF SCREEN OR PERFORATION MATERIAL: X PVC 10 Asbestos-Cement

1 Steel 3 Stainless Steel 5 Fiberglass 8 RMP (SR) 11 Other (Specify)
 2 Brass 4 Galvanized Steel 6 Concrete tile 9 ABS 12 None used (open hole)

SCREEN OR PERFORATION OPENINGS ARE: 5 Guaged wrapped 8 Saw cut 11 None (open hole)

1 Continuous slot X 3 Mill slot 6 Wire wrapped 9 Drilled holes
 2 Louvered shutter 4 Key punched 7 Torch cut 10 Other (specify) 10 ft.



What is the nearest source of possible contamination: 10 Livestock pens 14 Abandoned water well

X 1 Septic tank 4 Lateral lines 7 Pit privy 11 Fuel storage 15 Oil well/Gas wellX 2 Sewer lines 5 Cess pool 8 Sewage lagoon 12 Fertilizer storage 16 Other (specify below)

3 Watertight sewer lines 6 Seepage pit 9 Feedyard 13 Insecticide storage

Direction from well? SW How many feet? 150

FROM TO LITHOLOGIC LOG FROM TO PLUGGING INTERVALS

0 8 BLACK TOP SOIL8 18 Tan Clay18 50 Fine Sand B/K

INSTRUCTIONS: Use typewriter or ball point pen. PLEASE PRESS FIRMLY and PRINT clearly. Please fill in blanks, underline or circle the correct answers. Send top three copies to Kansas Department of Health and Environment, Bureau of Water, Geology Section, 1000 SW Jackson St., Suite 420, Topeka, Kansas 66612-1367. Telephone 785-296-5522. Send one to WATER WELL OWNER and retain one for your records. Fee of \$5.00 for each constructed well.

7 CONTRACTOR'S OR LANDOWNER'S CERTIFICATION: This water well was X constructed, (2) reconstructed, or (3) plugged under my jurisdiction and was completed on (mo/day/year) 6-16-06 and this record is true to the best of my knowledge and belief. Kansas Water Well Contractor's Licence No. 671 This Water Well Record was completed on (mo/day/yr) 6-21-06 under the business name of Crow's Creek Well by (signature) Ted J. Sheer, Jr.