


WATER WELL RECORD

Form WWC-5

Division of Water Resources App. No.

1 LOCATION OF WATER WELL: County: Kingman, Fraction NE 1/4 NE 1/4 SW 1/4, Section Number 11, Township No. T 27 S, Range Number R 6 E W. 2 WATER WELL OWNER: Stan Jones, RR#, Street Address, Box #: 4471 N. State Rd 17, City, State, ZIP Code: Pretty Prairie, KS 67570.

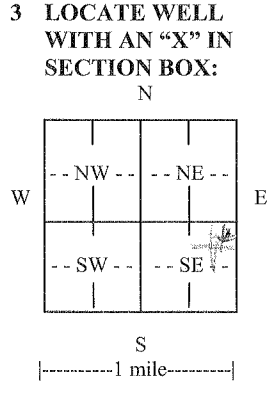

4 DEPTH OF COMPLETED WELL: 90 ft. Depth(s) Groundwater Encountered (1)..... ft. (2)..... ft. (3)..... ft. WELL'S STATIC WATER LEVEL..... ft. below land surface measured on mo/day/yr..... Pump test data: Well water was..... ft. after..... hours pumping..... gpm EST. YIELD..... gpm. Well water was..... ft. after..... hours pumping..... gpm Bore Hole Diameter..... in. to..... ft., and..... in. to..... ft. WELL WATER TO BE USED AS: [X] Domestic [] Feedlot [] Oil field water supply [] Geothermal [] Injection well [] Irrigation [] Industrial [] Domestic-lawn & garden [] Dewatering [] Other (Specify below) [] Monitoring well Was a chemical/bacteriological sample submitted to Department? [] Yes [X] No If yes, mo/day/yr sample was submitted..... Water well disinfected? [X] Yes [] No

5 TYPE OF CASING USED: [] Steel [X] PVC [] Other CASING JOINTS: [X] Glued [] Clamped [] Welded [] Threaded Casing diameter..... 5 in. to..... 90 ft., Diameter..... in. to..... ft., Diameter..... in. to..... ft. Casing height above land surface..... 16 in., Weight..... 160 lbs./ft., Wall thickness or gauge No. 26 TYPE OF SCREEN OR PERFORATION MATERIAL: [] Steel [] Stainless Steel [X] PVC [] Other (Specify) [] Brass [] Galvanized Steel [] None used (open hole) SCREEN OR PERFORATION OPENINGS ARE: [] Continuous slot [X] Mill slot [] Gauze wrapped [] Torch cut [] Drilled holes [] None (open hole) [] Louvered shutter [] Key punched [] Wire wrapped [] Saw cut [] Other (specify) SCREEN-PERFORATED INTERVALS: From..... 70 ft. to..... 90 ft., From..... ft. to..... ft. From..... ft. to..... ft., From..... ft. to..... ft. GRAVEL PACK INTERVALS: From..... 24 ft. to..... 90 ft., From..... ft. to..... ft. From..... ft. to..... ft., From..... ft. to..... ft.

6 GROUT MATERIAL: [] Neat cement [] Cement grout [X] Bentonite [] Other Grout Intervals: From..... 4 ft. to..... 24 ft., From..... ft. to..... ft., From..... ft. to..... ft. What is the nearest source of possible contamination: [X] Septic tank [] Lateral lines [] Pit privy [] Livestock pens [] Insecticide storage [] Other (specify below) [] Sewer lines [] Cesspool [] Sewage lagoon [] Fuel storage [] Abandoned water well [] Watertight sewer lines [] Seepage pit [] Feedyard [] Fertilizer storage [] Oil well/gas well Direction from well..... South Distance from well..... 220'

FROM	TO	LITHOLOGIC LOG	FROM	TO	LITHO. LOG (cont.) or PLUGGING INTERVALS
0	2	TOPSOIL			
2	9	Sandy Clay			
9	28	Fine Silty Sand			
28	61	Red Shale			
61	80	Red & green Shale			

7 CONTRACTOR'S OR LANDOWNER'S CERTIFICATION: This water well was [X] constructed, [] reconstructed, or [] plugged under my jurisdiction and was completed on (mo/day/year) 12:12:11 and this record is true to the best of my knowledge and belief. Kansas Water Well Contractor's License No. 611.... This Water Well Record was completed on (mo/day/year) 1:5:11 under the business name of Chase Drilling by (signature)..... ID Chase

INSTRUCTIONS: Use typewriter or ball point pen. PLEASE PRESS FIRMLY and PRINT clearly. Please fill in blanks and check the correct answers. Send three copies (white, blue, pink) to Kansas Department of Health and Environment, Bureau of Water, Geology Section, 1000 SW Jackson St., Suite 420, Topeka, Kansas 66612-1367. Telephone 785-296-5524. Send one copy to WATER WELL OWNER and retain one for your records. Include fee of \$5.00 for each constructed well. Visit us at http://www.kdheks.gov/waterwell/index.html.