WATER WELL PLUGGING RECORD Form WWC-5P KSA 82a-1212 ID NO.

1 LOCATION OF WATER WELL: County: Kingman	Fraction: SE ¼ SW ¼ SW ¼	Section Number: 21	Township Number: 27 S	Range Number: 6 E/W

Distance and direction from nearest town or city street address of well if located within city? From US 400 & NE 70 Ave. E. of Kingman go N. .5 mls. to NE 20th St. go E. .25 mls. & N. into

2 WATER WELL OWNER: Magellan Ammonia Pipeline Co.

RR#, St. Address, Box #: One Williams Center/MD-29

City, State ZIP Code: Tulsa, OK 74172

Global Positioning Systems (decimal degrees, min. of 4 digits)
Latitude: 37.477253
Longitude: -97.987225
Elevation: 1492
Datum: Nad 83
Data Collection Method:

3 MARK WELL'S LOCATION WITH AN "X" IN SECTION BOX:

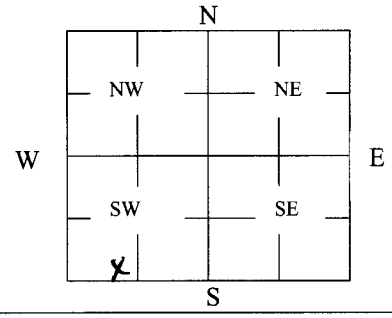

4 DEPTH OF WELL 15 ft. MW 13

WELL'S STATIC WATER LEVEL _____ ft

WELL WAS USED AS:

1 Domestic	5 Public Water Supply	9 Dewatering
2 Irrigation	6 Oil Field Water Supply	10 Monitoring
3 Feedlot	7 Domestic (Lawn & Garden)	11 Injection Well
4 Industrial	8 Air Conditioning	12 Other _____

Was a chemical/bacteriological sample submitted to Department? Yes _____ No X

5 TYPE OF BLANK CASING USED:

1 Steel	3 RMP (SR)	5 Wrought	7 Fiberglass	9 Other (Specify below)
2 PVC	4 ABS	6 Asbestos-Cement	8 Concrete Tile	

Blank casing diameter 2 in. Was casing pulled? Yes X No _____ If yes, how much All

Casing height above or below land surface 30 in.

6 GROUT PLUG MATERIAL: 1 Neat cement 2 Cement grout 3 Bentonite 4 Other _____

Grout Plug Intervals: From 1 ft. to 15 ft., From _____ ft. to _____ ft., From _____ to _____ ft.

What is the nearest source of possible contamination:

1 Septic tank	6 Seepage pit	11 Fuel Storage	16 Other (specify below)
2 Sewer lines	7 Pit privy	12 Fertilizer storage	Ammonia Line
3 Watertight sewer lines	8 Sewage lagoon	13 Insecticide storage	
4 Lateral lines	9 Feedyard	14 Abandoned water well	Direction from well? East
5 Cess pool	10 Livestock pens	15 Oil well/Gas well	How many feet? 1600

FROM	TO	PLUGGING MATERIALS	FROM	TO	PLUGGING MATERIALS
1	15	Bentonite			

7 CONTRACTOR'S OR LANDOWNER'S CERTIFICATION: This water well was plugged under my jurisdiction and was completed on (mo/day/year) 11/28/12 and this record is true to the best of my knowledge and belief. Kansas Water Well Contractor's License No. 676. This Water Well Record was completed on (mo/day/year) 12/17/12 under the business name of Whitetail Drilling, LLC by (signature) Chet Bass

INSTRUCTIONS: Use typewriter or ballpoint pen. Please press firmly and print clearly. Please fill in blanks, underline or circle the correct answers. Send top three copies to Kansas Department of Health and Environment, Bureau of Water, Geology Section, 1000 SW Jackson St., Ste. 420, Topeka, Kansas 66612-1367. Telephone: 785/296-5522. Send one to Water Well Owner and retain one for your records. Visit us at http://www.kdheks.gov/geo/waterwells.