


1 LOCATION OF WATER WELL: County: Kingman Fraction: SE 1/4 SE 1/4 SW 1/4 Section Number: 30 Township Number: T 27 S Range Number: R 7 W

Distance and direction from nearest town or city street address of well if located within city?
1 mile west of main st. 1 mile west on Kansas ave.

2 WATER WELL OWNER: John Hoover
 RR#, St. Address, Box #: RT#1 Board of Agriculture, Division of Water Resources
 City, State, ZIP Code: Kingman, Kans. 67068 Application Number:

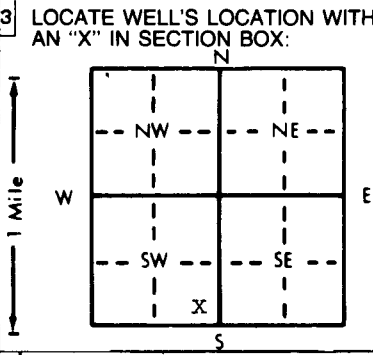

4 DEPTH OF COMPLETED WELL: 31' ft. ELEVATION:
 Depth(s) Groundwater Encountered 1. 5' ft. 2. ft. 3. ft.
 WELL'S STATIC WATER LEVEL: 5' ft. below land surface measured on mo/day/yr Oct. 3 - 95
 Pump test data: Well water was ft. after hours pumping gpm
 Est. Yield: 25 gpm; Well water was NA ft. after hours pumping gpm
 Bore Hole Diameter: 7.7/8" in. to 31' ft., and in. to ft.
 WELL WATER TO BE USED AS:
 Public water supply Air conditioning Injection well
 Domestic Feedlot Oil field water supply Dewatering Other (Specify below)
 Irrigation Industrial Lawn and garden only Monitoring well
 Was a chemical/bacteriological sample submitted to Department? Yes.....No.....; If yes, mo/day/yr sample was submitted
 Water Well Disinfected? Yes No

5 TYPE OF BLANK CASING USED:
 1 Steel PVC 3 RMP (SR) 4 ABS 5 Wrought iron 6 Asbestos-Cement 7 Fiberglass 8 Concrete tile 9 Other (specify below)
 CASING JOINTS: Glued Clamped Welded Threaded
 Blank casing diameter: 5" in. to 22" ft., Dia. in. to ft., Dia. in. to ft.
 Casing height above land surface: 14" in., weight 160 lbs./ft. Wall thickness or gauge No. SDR26
 TYPE OF SCREEN OR PERFORATION MATERIAL:
 Steel Stainless steel Fiberglass PVC RMP (SR) Asbestos-cement
 Brass Galvanized steel Concrete tile ABS Other (specify)
 None used (open hole)
 SCREEN OR PERFORATION OPENINGS ARE:
 Continuous slot Mill slot Gauzed wrapped Saw cut None (open hole)
 Louvered shutter Key punched Wire wrapped Drilled holes
 Torch cut Other (specify)
 SCREEN-PERFORATED INTERVALS: From 22' ft. to 31' ft., From ft. to ft.
 GRAVEL PACK INTERVALS: From ft. to ft., From ft. to ft.
 From 31' ft. to 21' ft., From ft. to ft.

6 GROUT MATERIAL: 1 Neat cement 2 Cement grout Bentonite 4 Other
 Grout Intervals: From 21' ft. to 3' ft., From ft. to ft., From ft. to ft.
 What is the nearest source of possible contamination:
 Septic tank Lateral lines Pit privy Livestock pens Abandoned water well
 Sewer lines Cess pool Sewage lagoon Fuel storage Oil well/Gas well
 Watertight sewer lines Seepage pit Feedyard Fertilizer storage Other (specify below)
 Insecticide storage
 Direction from well? South East How many feet? 140'

FROM	TO	LITHOLOGIC LOG	FROM	TO	PLUGGING INTERVALS
0'	2'	Top Soil.			
2'	8'	Fine Sand.			
8'	19'	Course Sand & Fine Gravel.			
19'	21'	Brown Clay.			
21'	29'	Medium Course Sand.			
29'	31'	Red bed.			

7 CONTRACTOR'S OR LANDOWNER'S CERTIFICATION: This water well was (1) constructed, (2) reconstructed, or (3) plugged under my jurisdiction and was completed on (mo/day/year) Oct. 3 - 1995 and this record is true to the best of my knowledge and belief. Kansas Water Well Contractor's License No. 112 This Water Well Record was completed on (mo/day/yr) OCT. 18 - 1995 under the business name of Wells Drilling Co. by (signature) Dal Wells

INSTRUCTIONS: Use typewriter or ball point pen. PLEASE PRESS FIRMLY and PRINT clearly. Please fill in blanks, underline or circle the correct answers. Send top three copies to Kansas Department of Health and Environment, Bureau of Water, Topeka, Kansas 66620-0001. Telephone: 913-296-5545. Send one to WATER WELL OWNER and retain one for your records.