


1 LOCATION OF WATER WELL: Fraction SE 1/4 NE 1/4 SW 1/4 Section Number 30 Township Number T 27 S Range Number R 7 E  
 County: Kingman

Distance and direction from nearest town or city street address of well if located within city?  
1901 Industrial Ave. Kingman, Kans Northwest part of town or west of air port

2 WATER WELL OWNER: Bill Lindt  
 RR#, St. Address, Box #: 1901 Industrial Ave. Board of Agriculture, Division of Water Resources  
 City, State, ZIP Code: Kingman, Kans. 67068 Application Number:

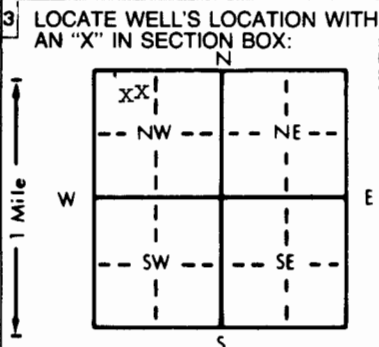

4 DEPTH OF COMPLETED WELL: 38' ft. ELEVATION: .....  
 Depth(s) Groundwater Encountered 1. 8' 6" ft. 2. .... ft. 3. .... ft.  
 WELL'S STATIC WATER LEVEL 8' 6" ft. below land surface measured on mo/day/yr Feb. 25 - 1996  
 Pump test data: Well water was ..... ft. after ..... hours pumping ..... gpm  
 Est. Yield 40 gpm: Well water was NA ft. after ..... hours pumping ..... gpm  
 Bore Hole Diameter 7 7/8" in. to 38' ft., and ..... in. to ..... ft.  
 WELL WATER TO BE USED AS:  
XX 1 Domestic 3 Feedlot 6 Oil field water supply 9 Dewatering 12 Other (Specify below)  
 2 Irrigation 4 Industrial 7 Lawn and garden only 10 Monitoring well .....  
 Was a chemical/bacteriological sample submitted to Department? Yes.....No.....X; If yes, mo/day/yr sample was submitted  
 Water Well Disinfected? Yes X No

5 TYPE OF BLANK CASING USED:  
 1 Steel 3 RMP (SR) 5 Wrought iron 8 Concrete tile CASING JOINTS: Glued X Clamped .....  
XX 2 PVC 4 ABS 6 Asbestos-Cement 9 Other (specify below) Welded .....  
 7 Fiberglass Threaded.....  
 Blank casing diameter 5" in. to 26' ft., Dia ..... in. to ..... ft., Dia ..... in. to ..... ft.  
 Casing height above land surface 16" in., weight 160 lbs./ft. Wall thickness or gauge No. SDR 26  
 TYPE OF SCREEN OR PERFORATION MATERIAL:  
 1 Steel 3 Stainless steel 5 Fiberglass 8 RMP (SR) 10 Asbestos-cement 11 Other (specify) .....  
 2 Brass 4 Galvanized steel 6 Concrete tile 9 ABS 12 None used (open hole)  
 SCREEN OR PERFORATION OPENINGS ARE:  
 1 Continuous slot 3 Mill slot 5 Gauzed wrapped XX 8 Saw cut 11 None (open hole)  
 2 Louvered shutter 4 Key punched 6 Wire wrapped 9 Drilled holes  
 7 Torch cut 10 Other (specify) .....  
 SCREEN-PERFORATED INTERVALS: From ..... ft. to ..... ft., From ..... ft. to ..... ft.  
 From 38' ft. to 26' ft., From ..... ft. to ..... ft.  
 GRAVEL PACK INTERVALS: From ..... ft. to ..... ft., From ..... ft. to ..... ft.  
 From 38' ft. to 25' ft., From ..... ft. to ..... ft.

6 GROUT MATERIAL: 1 Neat cement 2 Cement grout XXX 3 Bentonite 4 Other .....  
 Grout Intervals: From 26' ft. to 3' ft., From ..... ft. to ..... ft., From ..... ft. to ..... ft.  
 What is the nearest source of possible contamination:  
 1 Septic tank 4 Lateral lines 7 Pit privy XX 10 Livestock pens 14 Abandoned water well  
 2 Sewer lines 5 Cess pool 8 Sewage lagoon 11 Fuel storage 15 Oil well/Gas well  
 3 Watertight sewer lines 6 Seepage pit 9 Feedyard 12 Fertilizer storage 16 Other (specify below)  
 13 Insecticide storage .....  
 Direction from well? West How many feet? App. 500'

FROM	TO	LITHOLOGIC LOG	FROM	TO	PLUGGING INTERVALS
0'	4'	Sandy top soil.			
4'	8'	Clay.			
8'	12'	Medium course sand.			
12'	17'	Sandy clay.			
17'	21'	Fine Sand.			
21'	24'	Clay.			
24'	38'	Course sand.			
38'		Red Bed.			

7 CONTRACTOR'S OR LANDOWNER'S CERTIFICATION: This water well was (1) constructed, (2) reconstructed, or (3) plugged under my jurisdiction and was completed on (mo/day/year) Feb. 25 1996 and this record is true to the best of my knowledge and belief. Kansas Water Well Contractor's License No. 112 This Water Well Record was completed on (mo/day/yr) Mar. 21 1996 under the business name of Wells Drilling Co. by (signature) Dal Wells