


1 LOCATION OF WATER WELL: County: Kingman Fraction: SE 1/4 SW 1/4 SW 1/4 Section Number: 30 Township Number: T 27 S Range Number: R 7 E/W

Distance and direction from nearest town or city street address of well if located within city?
2015 No. Abby Rd. North west part of Kingman - West on Kansas Ave To Abby Rd.

2 WATER WELL OWNER: Bob Walters
 RR#, St. Address, Box #: 2015 No. Abby Rd. Board of Agriculture, Division of Water Resources
 City, State, ZIP Code: Kingman, Kans. 67068 Application Number:

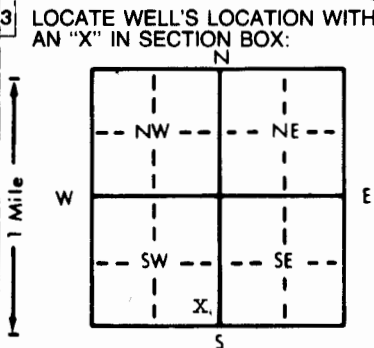

4 DEPTH OF COMPLETED WELL: 56' ft. ELEVATION: ft.
 Depth(s) Groundwater Encountered 1. ft. 2. ft. 3. ft.
 WELL'S STATIC WATER LEVEL 22' ft. below land surface measured on mo/day/yr April 25-1996
 Pump test data: Well water was 35 ft. after hours pumping gpm
 Est. Yield 35 gpm: Well water was NA ft. after hours pumping gpm
 Bore Hole Diameter 7.7/8" in. to 56' ft., and in. to ft.
 WELL WATER TO BE USED AS:
 5 Public water supply 8 Air conditioning 11 Injection well
 1 Domestic 3 Feedlot 6 Oil field water supply 9 Dewatering 12 Other (Specify below)
 2 Irrigation 4 Industrial X7 Lawn and garden only 10 Monitoring well
 Was a chemical/bacteriological sample submitted to Department? Yes.....No. X.....; If yes, mo/day/yr sample was submitted
 Water Well Disinfected? Yes No

5 TYPE OF BLANK CASING USED:
 1 Steel 3 RMP (SR) 5 Wrought iron 8 Concrete tile CASING JOINTS: Glued XX Clamped
XX2 PVC 4 ABS 6 Asbestos-Cement 9 Other (specify below) Welded
 7 Fiberglass Threaded
 Blank casing diameter 5" in. to 46 ft., Dia in. to ft., Dia in. to ft.
 Casing height above land surface 15" in., weight 160 lbs./ft. Wall thickness or gauge No. Sdr26
 TYPE OF SCREEN OR PERFORATION MATERIAL: XX7 PVC 10 Asbestos-cement
 1 Steel 3 Stainless steel 5 Fiberglass 8 RMP (SR) 11 Other (specify)
 2 Brass 4 Galvanized steel 6 Concrete tile 9 ABS 12 None used (open hole)
 SCREEN OR PERFORATION OPENINGS ARE:
 5 Gauzed wrapped XX Saw cut 11 None (open hole)
 1 Continuous slot 3 Mill slot 6 Wire wrapped 9 Drilled holes
 2 Louvered shutter 4 Key punched 7 Torch cut 10 Other (specify)
 SCREEN-PERFORATED INTERVALS: From 46' ft. to 56' ft., From ft. to ft.
 From ft. to ft., From ft. to ft.
 GRAVEL PACK INTERVALS: From XX2 56 ft. to 23' ft., From ft. to ft.
 From ft. to ft., From ft. to ft.

6 GROUT MATERIAL: 1 Neat cement 2 Cement grout XX3 Bentonite 4 Other
 Grout Intervals: From 23' ft. to 3' ft., From ft. to ft., From ft. to ft.
 What is the nearest source of possible contamination:
 1 Septic tank 4 Lateral lines 7 Pit privy XX0 Livestock pens 14 Abandoned water well
 2 Sewer lines 5 Cess pool 8 Sewage lagoon 11 Fuel storage 15 Oil well/Gas well
 3 Watertight sewer lines 6 Seepage pit 9 Feedyard 12 Fertilizer storage 16 Other (specify below)
 13 Insecticide storage
 Direction from well? West How many feet? 150'

FROM	TO	LITHOLOGIC LOG	FROM	TO	PLUGGING INTERVALS
0'	3'	Top Soil			
3'	5'	Fine sand.			
5'	11'	Brown clay.			
11'	13'	Course sand.			
13'	15'	Brown clay.			
15'	22'	Course sand & Gravel.			
22'	31'	Brown clay.			
31'	35'	Fine sand.			
35'	41'	Medium Fine sand & clay.			
41'	46'	Red clay.			
46'	55'	Course sand.			
55'	56'	Red bed.			

7 CONTRACTOR'S OR LANDOWNER'S CERTIFICATION: This water well was (1) constructed, (2) reconstructed, or (3) plugged under my jurisdiction and was completed on (mo/day/year) April 25 1996 and this record is true to the best of my knowledge and belief. Kansas Water Well Contractor's License No. 112 This Water Well Record was completed on (mo/day/yr) May 27 1996 under the business name of Wells Drilling Co. by (signature) Dal Wells