


1 LOCATION OF WATER WELL: County: Kingman Fraction SE  $\frac{1}{4}$  NW  $\frac{1}{4}$  NW  $\frac{1}{4}$  Section Number 31 Township Number T 27 S Range Number R 7 W

Distance and direction from nearest town or city street address of well if located within city?  
1340 West Kelly-North part of Town of Kingman, Kns. Or North of Country Club 1 Block. (Lot 7)

2 WATER WELL OWNER: Kelly Mason  
 RR#, St. Address, Box #: 1340 West Kelly  
 City, State, ZIP Code: Kingman, Kans. 67068  
 Board of Agriculture, Division of Water Resources  
 Application Number:

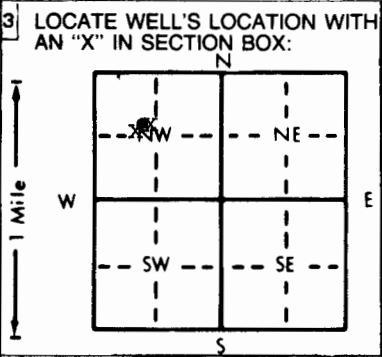

4 DEPTH OF COMPLETED WELL: 46' ft. ELEVATION:  
 Depth(s) Groundwater Encountered 1. 21 ft. 2. \_\_\_\_\_ ft. 3. \_\_\_\_\_ ft.  
 WELL'S STATIC WATER LEVEL: 21' ft. below land surface measured on mo/day/yr April 30-96  
 Pump test data: Well water was XX3 ft. after \_\_\_\_\_ hours pumping \_\_\_\_\_ gpm  
 Est. Yield 35 gpm: Well water was NA ft. after \_\_\_\_\_ hours pumping \_\_\_\_\_ gpm  
 Bore Hole Diameter: 7 7/8" in. to 46' ft., and \_\_\_\_\_ in. to \_\_\_\_\_ ft.  
 WELL WATER TO BE USED AS:  
 5 Public water supply 8 Air conditioning 11 Injection well  
 1 Domestic 3 Feedlot 6 Oil field water supply 9 Dewatering 12 Other (Specify below)  
 2 Irrigation 4 Industrial XX7 Lawn and garden only 10 Monitoring well  
 Was a chemical/bacteriological sample submitted to Department? Yes \_\_\_\_\_ No X; If yes, mo/day/yr sample was submitted \_\_\_\_\_  
 Water Well Disinfected? Yes X No \_\_\_\_\_

5 TYPE OF BLANK CASING USED:  
 1 Steel 3 RMP (SR) 5 Wrought iron 8 Concrete tile CASING JOINTS: Glued X Clamped \_\_\_\_\_  
XX2 PVC 4 ABS 7 Fiberglass \_\_\_\_\_ Welded \_\_\_\_\_  
 Blank casing diameter 5" in. to 33' ft., Dia \_\_\_\_\_ in. to \_\_\_\_\_ ft., Dia \_\_\_\_\_ in. to \_\_\_\_\_ ft.  
 Casing height above land surface 14" in., weight 160 lbs./ft. Wall thickness or gauge No. SDR 26  
 TYPE OF SCREEN OR PERFORATION MATERIAL:  
 1 Steel 3 Stainless steel 5 Fiberglass XX7 PVC 10 Asbestos-cement  
 2 Brass 4 Galvanized steel 6 Concrete tile 8 RMP (SR) 11 Other (specify) \_\_\_\_\_  
 9 ABS 12 None used (open hole)  
 SCREEN OR PERFORATION OPENINGS ARE:  
 1 Continuous slot 3 Mill slot 5 Gauzed wrapped XX8 Saw cut 11 None (open hole)  
 2 Louvered shutter 4 Key punched 6 Wire wrapped 9 Drilled holes  
 7 Torch cut 10 Other (specify) \_\_\_\_\_  
 SCREEN-PERFORATED INTERVALS: From 46' ft. to 33' ft., From \_\_\_\_\_ ft. to \_\_\_\_\_ ft.  
 From \_\_\_\_\_ ft. to \_\_\_\_\_ ft., From \_\_\_\_\_ ft. to \_\_\_\_\_ ft.  
 GRAVEL PACK INTERVALS: From \_\_\_\_\_ ft. to \_\_\_\_\_ ft., From \_\_\_\_\_ ft. to \_\_\_\_\_ ft.  
 From 46' ft. to 38' 25' ft., From \_\_\_\_\_ ft. to \_\_\_\_\_ ft.

6 GROUT MATERIAL: 1 Neat cement 2 Cement grout XX3 Bentonite 4 Other \_\_\_\_\_  
 Grout Intervals: From 25' ft. to 3' ft., From \_\_\_\_\_ ft. to \_\_\_\_\_ ft., From \_\_\_\_\_ ft. to \_\_\_\_\_ ft.  
 What is the nearest source of possible contamination:  
 1 Septic tank 4 Lateral lines 7 Pit privy XX10 Livestock pens 14 Abandoned water well  
 2 Sewer lines 5 Cess pool 8 Sewage lagoon 11 Fuel storage 15 Oil well/Gas well  
 3 Watertight sewer lines 6 Seepage pit 9 Feedyard 12 Fertilizer storage 16 Other (specify below)  
 13 Insecticide storage  
 Direction from well? North How many feet? App. 1320'

FROM	TO	LITHOLOGIC LOG	FROM	TO	PLUGGING INTERVALS
0'	2'	Top soil.			
2'	7'	Fine sand.			
7'	8'	Clay.			
8'	18'	Course sand W/ clay strips.			
18'	19'	Clay.			
19'	22'	Fine sand -Clay.			
22'	27'	Brown clay.			
27'	32'	Medium fine sand.			
32'	40'	Course sand.			
40'	44'	Red clay.			
44'	46'	Red bed.			

7 CONTRACTOR'S OR LANDOWNER'S CERTIFICATION: This water well was (1) constructed, (2) reconstructed, or (3) plugged under my jurisdiction and was completed on (mo/day/year) April 30, 1996 and this record is true to the best of my knowledge and belief. Kansas Water Well Contractor's License No. 112 This Water Well Record was completed on (mo/day/yr) May 27, 1996 under the business name of Wells Drilling Co. by (signature) Dal Wells