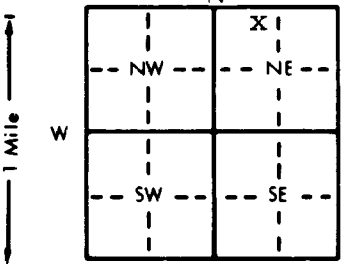


1 LOCATION OF WATER WELL: County: Kingman Fraction: NE 1/4 NW 1/4 NE 1/4 Section Number: 33 Township Number: T 27 S Range Number: R 7 ~~EAW~~ ~~XX~~
 Distance and direction from nearest town or city street address of well if located within city?

1 Mile north on Marquette ST - 3/4 Mile East Of Kingman'Kns.

2 WATER WELL OWNER: Alfred Jones
 RR#, St. Address, Box #: 100-G ~~Box~~ RT# 2 Board of Agriculture, Division of Water Resources
 City, State, ZIP Code: Kingman, Kans. 67068 Application Number:

3 LOCATE WELL'S LOCATION WITH AN "X" IN SECTION BOX:

 4 DEPTH OF COMPLETED WELL: 75' ft. ELEVATION:
 Depth(s) Groundwater Encountered 1. 16' ft. 2. ft. 3. ft.
 WELL'S STATIC WATER LEVEL 8' ft. below land surface measured on mo/day/yr Jan. - 2000
 Pump test data: Well water was NA ft. after hours pumping gpm
 Est. Yield 1.8 gpm: Well water was ft. after hours pumping gpm
 Bore Hole Diameter 77/8" to 75' ft., and in. to ft.
 WELL WATER TO BE USED AS:
 5 Public water supply 8 Air conditioning 11 Injection well
 X1 Domestic 3 Feedlot 6 Oil field water supply 9 Dewatering 12 Other (Specify below)
 2 Irrigation 4 Industrial 7 Lawn and garden only 10 Monitoring well
 Was a chemical/bacteriological sample submitted to Department? Yes No XX If yes, mo/day/yr sample was submitted
 Water Well Disinfected? Yes X No

5 TYPE OF BLANK CASING USED:
 1 Steel 3 RMP (SR) 5 Wrought iron 8 Concrete tile CASING JOINTS: Glued X Clamped
 2 PVC XX 4 ABS 6 Asbestos-Cement 9 Other (specify below) Welded
 7 Fiberglass Threaded
 Blank casing diameter 5" in. to 6.5' ft., Dia in. to ft., Dia in. to ft.
 Casing height above land surface 15" in., weight 355 lbs./ft. Wall thickness or gauge No. 214
 TYPE OF SCREEN OR PERFORATION MATERIAL:
 1 Steel 3 Stainless steel 5 Fiberglass 8 RMP (SR) 10 Asbestos-cement
 2 Brass 4 Galvanized steel 6 Concrete tile 9 ABS 12 None used (open hole)
 SCREEN OR PERFORATION OPENINGS ARE:
 1 Continuous slot XX Mill slot 5 Gauzed wrapped 8 Saw cut 11 None (open hole)
 2 Louvered shutter 4 Key punched 7 Torch cut 9 Drilled holes
 SCREEN-PERFORATED INTERVALS: From 75' ft. to ft., From ft. to ft.
 From ft. to 65' ft., From ft. to ft.
 GRAVEL PACK INTERVALS: From 75' ft. to 26' ft., From ft. to ft.
 From ft. to ft., From ft. to ft.

6 GROUT MATERIAL: 1 Neat cement 2 Cement grout XX 3 Bentonite 4 Other
 Grout Intervals: From 26' ft. to 0' ft., From ft. to ft., From ft. to ft.
 What is the nearest source of possible contamination:
 1 Septic tank XX 4 Lateral lines 7 Pit privy 10 Livestock pens 14 Abandoned water well
 2 Sewer lines 5 Cess pool 8 Sewage lagoon 11 Fuel storage 15 Oil well/Gas well
 3 Watertight sewer lines 6 Seepage pit 9 Feedyard 12 Fertilizer storage 16 Other (specify below)
 13 Insecticide storage
 Direction from well? North East How many feet? APP: 300'

FROM	TO	LITHOLOGIC LOG	FROM	TO	PLUGGING INTERVALS
0'	3'	Top Soil.			
3'	8'	Fine Sand.			
8'	10'	Grey Clay.			
10'	16'	Course Sand & Gravel.			
16'	62'	Red Bed.			
16'	73'	Broken Red bed.			
73'	75'	Red Bed'			

7 CONTRACTOR'S OR LANDOWNER'S CERTIFICATION: This water well was (1) constructed, (2) reconstructed, or (3) plugged under my jurisdiction and was completed on (mo/day/year) Jan. 22-2000 and this record is true to the best of my knowledge and belief. Kansas Water Well Contractor's License No. 112 This Water Well Record was completed on (mo/day/yr) Feb. 15, 2000 under the business name of Wells Drilling Co by (signature) Bob Wells

OFFICE USE ONLY

T

R

EW

SEC.

1/4

1/4

1/4

1/4

1/4