


1 LOCATION OF WATER WELL: Fraction NE 1/4 NE 1/4 NE 1/4 Section Number 1 Township Number T 27 S Range Number R 7W EW

Distance and direction from nearest town or city street address of well if located within city? 3/4 mile East of Varner Ks

2 WATER WELL OWNER: Scott Fleming RR#, St. Address, Box #: RR 1 City, State, ZIP Code: Pretty Prairie, Ks. 67570 Board of Agriculture, Division of Water Resources Application Number:

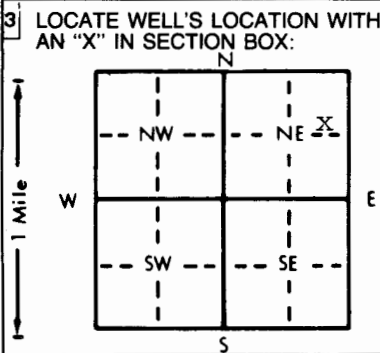

3 LOCATE WELL'S LOCATION WITH AN "X" IN SECTION BOX: 4 DEPTH OF COMPLETED WELL: 25 ft. ELEVATION: ... WELL'S STATIC WATER LEVEL: 5 ft. below land surface ...

5 TYPE OF BLANK CASING USED: 1 Steel, 3 RMP (SR), 5 Wrought iron, 8 Concrete tile, CASING JOINTS: Glued, Clamped, Welded, Threaded. ... SCREEN OR PERFORATION MATERIAL: 1 Steel, 3 Stainless steel, 5 Fiberglass, 8 RMP (SR), 11 Other (specify) ...

6 GROUT MATERIAL: 1 Neat cement, 2 Cement grout, 3 Bentonite, 4 Other Customer to do. ... What is the nearest source of possible contamination: 1 Septic tank, 4 Lateral lines, 7 Pit privy, 10 Livestock pens, 14 Abandoned water well ...

Direction from well? South How many feet? 150' Table with columns: FROM, TO, LITHOLOGIC LOG, FROM, TO, PLUGGING INTERVALS. Rows: 0-5 Top Soil, 5-10 Sand, 10-15 Sand, 15-20 Sand, 20-25 Sand, Clay, Shale.

7 CONTRACTOR'S OR LANDOWNER'S CERTIFICATION: This water well was (1) constructed, (2) reconstructed, or (3) plugged under my jurisdiction and was completed on (mo/day/year) 10/4/91 and this record is true to the best of my knowledge and belief. Kansas Water Well Contractor's License No. 134 This Water Well Record was completed on (mo/day/yr) 10-10-91 under the business name of Rosencrantz-Bemis by (signature) Dregg Dodson