


1 LOCATION OF WATER WELL: County: Kingman Fraction SE 1/4 SE 1/4 SW 1/4 Section Number 3 Township Number T 27 Range Number R 7 EW

Distance and direction from nearest town or city street address of well if located within city?
 13.4 East 330' North of Penalosa, Kansas

2 WATER WELL OWNER: H-30 Drilling Company
 RR#, St. Address, Box #: 251 N. Water Suite 10
 City, State, ZIP Code: Wichita, Kansas 67202 Lease: McCrutchen #1 Application Number: Board of Agriculture, Division of Water Resources

3 LOCATE WELL'S LOCATION WITH AN "X" IN SECTION BOX:

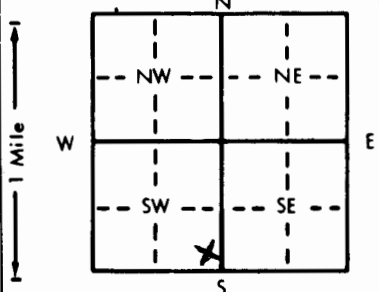

4 DEPTH OF COMPLETED WELL 55 ft. ELEVATION:

Depth(s) Groundwater Encountered 1. 11 ft. 2. ft. 3. ft.
 WELL'S STATIC WATER LEVEL .10 ft. below land surface measured on mo/day/yr 29 March 85
 Pump test data: Well water was ft. after hours pumping gpm
 Est. Yield .70 gpm: Well water was ft. after hours pumping gpm
 Bore Hole Diameter .10 in. to .55 ft., and in. to ft.
 WELL WATER TO BE USED AS:
 1 Domestic 3 Feedlot 6 Oil field water supply 9 Dewatering 12 Other (Specify below)
 2 Irrigation 4 Industrial 7 Lawn and garden only 10 Observation well
 Was a chemical/bacteriological sample submitted to Department? Yes No X; If yes, mo/day/yr sample was submitted Water Well Disinfected? Yes X No

5 TYPE OF BLANK CASING USED: 1 Steel 3 RMP (SR) 5 Wrought iron 8 Concrete tile CASING JOINTS: Glued X Clamped

Blank casing diameter .5 in. to .35 ft. Dia . in. to . ft. Dia . in. to . ft.
 Casing height above land surface .12 in., weight 2.34 lbs./ft. Wall thickness or gauge No. .214
 TYPE OF SCREEN OR PERFORATION MATERIAL: 7 PVC 10 Asbestos-cement

SCREEN OR PERFORATION OPENINGS ARE: 1 Continuous slot 3 Mill slot 5 Gauzed wrapped 8 RMP (SR) 11 Other (specify)
 2 Louvered shutter 4 Key punched 6 Wire wrapped 9 ABS 12 None used (open hole)
 7 Torch cut 10 Other (specify)

SCREEN-PERFORATED INTERVALS: From .35 ft. to .55 ft. From ft. to ft.
 GRAVEL PACK INTERVALS: From .10 ft. to .55 ft. From ft. to ft.

6 GROUT MATERIAL: 1 Neat cement 2 Cement grout 3 Bentonite 4 Other
 Grout Intervals: From .0 ft. to .10 ft. From ft. to ft. From ft. to ft.
 What is the nearest source of possible contamination:
 1 Septic tank 4 Lateral lines 7 Pit privy 11 Fuel storage 14 Abandoned water well
 2 Sewer lines 5 Cess pool 8 Sewage lagoon 12 Fertilizer storage 15 Oil well/Gas well
 3 Watertight sewer lines 6 Seepage pit 9 Feedyard 13 Insecticide storage 16 Other (specify below)
 Direction from well? How many feet?

FROM	TO	LITHOLOGIC LOG	FROM	TO	LITHOLOGIC LOG
0	2	Soil, top			
2	11	Clay, tan			
11	33	Sand, fine to coarse and fine gravel			
33	55	Sand, fine to coarse and fine to coarse gravel			
55	57	Shale, red			

7 CONTRACTOR'S OR LANDOWNER'S CERTIFICATION: This water well was (1) constructed, (2) reconstructed, or (3) plugged under my jurisdiction and was completed on (mo/day/year) 1 April 85 and this record is true to the best of my knowledge and belief. Kansas Water Well Contractor's License No. 325 This Water Well Record was completed on (mo/day/yr) 21 May 85 under the business name of Central Well & Pump Inc. by (signature) [Signature]

INSTRUCTIONS: Use typewriter or ball point pen, PLEASE PRESS FIRMLY and PRINT clearly. Please fill in blanks, underline or circle the correct answers. Send top three copies to Kansas Department of Health and Environment, Division of Environment, Environmental Geology Section, Topeka, KS 66620. Send one to WATER WELL OWNER and retain one for your records.